


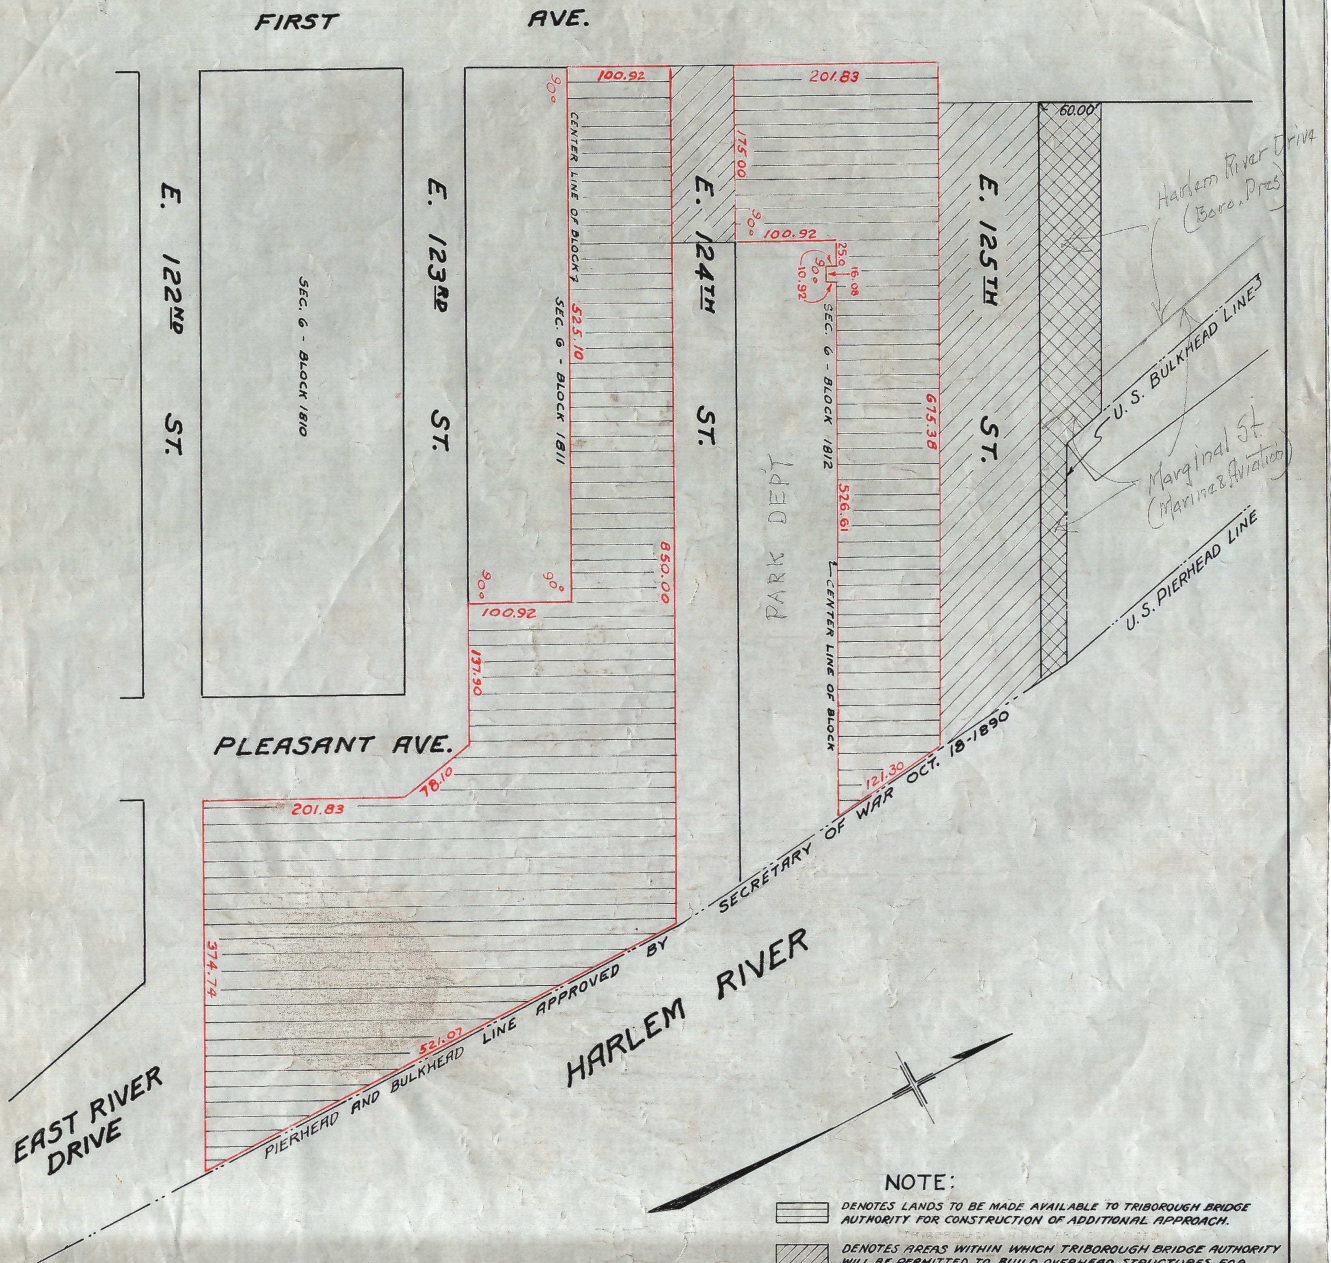

NOTE:

- DENOTES LANDS TO BE MADE AVAILABLE TO TRIBOROUGH BRIDGE AUTHORITY FOR CONSTRUCTION OF ADDITIONAL APPROACH.
- DENOTES AREAS WITHIN WHICH TRIBOROUGH BRIDGE AUTHORITY WILL BE PERMITTED TO BUILD OVERHEAD STRUCTURES FOR ADDITIONAL APPROACH, A CLEARANCE OF AT LEAST 14 FEET TO BE PROVIDED.
- DENOTES LANDS IN WHICH EASEMENT RIGHTS ARE TO BE MADE AVAILABLE.

TRIBOROUGH BRIDGE AUTHORITY
MAP OR PLAN
OF
MODIFIED APPROACH
TO
TRIBOROUGH BRIDGE
BOROUGH OF MANHATTAN

SECTION 442 GREATER
NEW YORK CHARTER

DATED: DEC. 3, 1934

SCALE: 1"=80'

I, PEARL DERNSTEIN, SECRETARY OF THE BOARD OF ESTIMATE AND APPORTIONMENT OF THE CITY OF NEW YORK, DO HEREBY CERTIFY THAT THIS MAP IS ONE OF THREE, SIMILAR MAPS MADE AT THE DIRECTION OF, AND ADOPTED BY THE SAID BOARD OF ESTIMATE AND APPORTIONMENT ON THE 22ND DAY OF ~~DECEMBER~~ JANUARY 1935, AND APPROVED BY THE MAYOR ON THE 22ND DAY OF ~~DECEMBER~~ JANUARY 1935, SUPERSEDING ALL MAPS HERETOFORE FILED AFFECTING THE AREA EMBRACED BY SAID MAP IN SO FAR AS IT MAKES ANY CHANGES THEREIN.

PREPARED FOR THE BOARD OF ESTIMATE AND APPORTIONMENT UNDER AUTHORITY OF THE CHARTER OF THE CITY OF NEW YORK,
DATED NEW YORK, JAN. 2, 1935

Pearl Bernstein
SECRETARY
BOARD OF ESTIMATE AND APPORTIONMENT

Pearl Bernstein
SECRETARY
BOARD OF ESTIMATE AND APPORTIONMENT

CORRECT Alfred Dana
ENGINEER OF DESIGN
APPROVED Alfred Dana
CHIEF ENGINEER
APPROVED Francis J. Ryan
ACTING DIRECTOR

DRAWING NO. 284

FILE NO. 100.2 ACC. NO. 27249

ACC: NO: # 27249

Filed in Office of Borough
Engineer Manhattan 1/15/35