


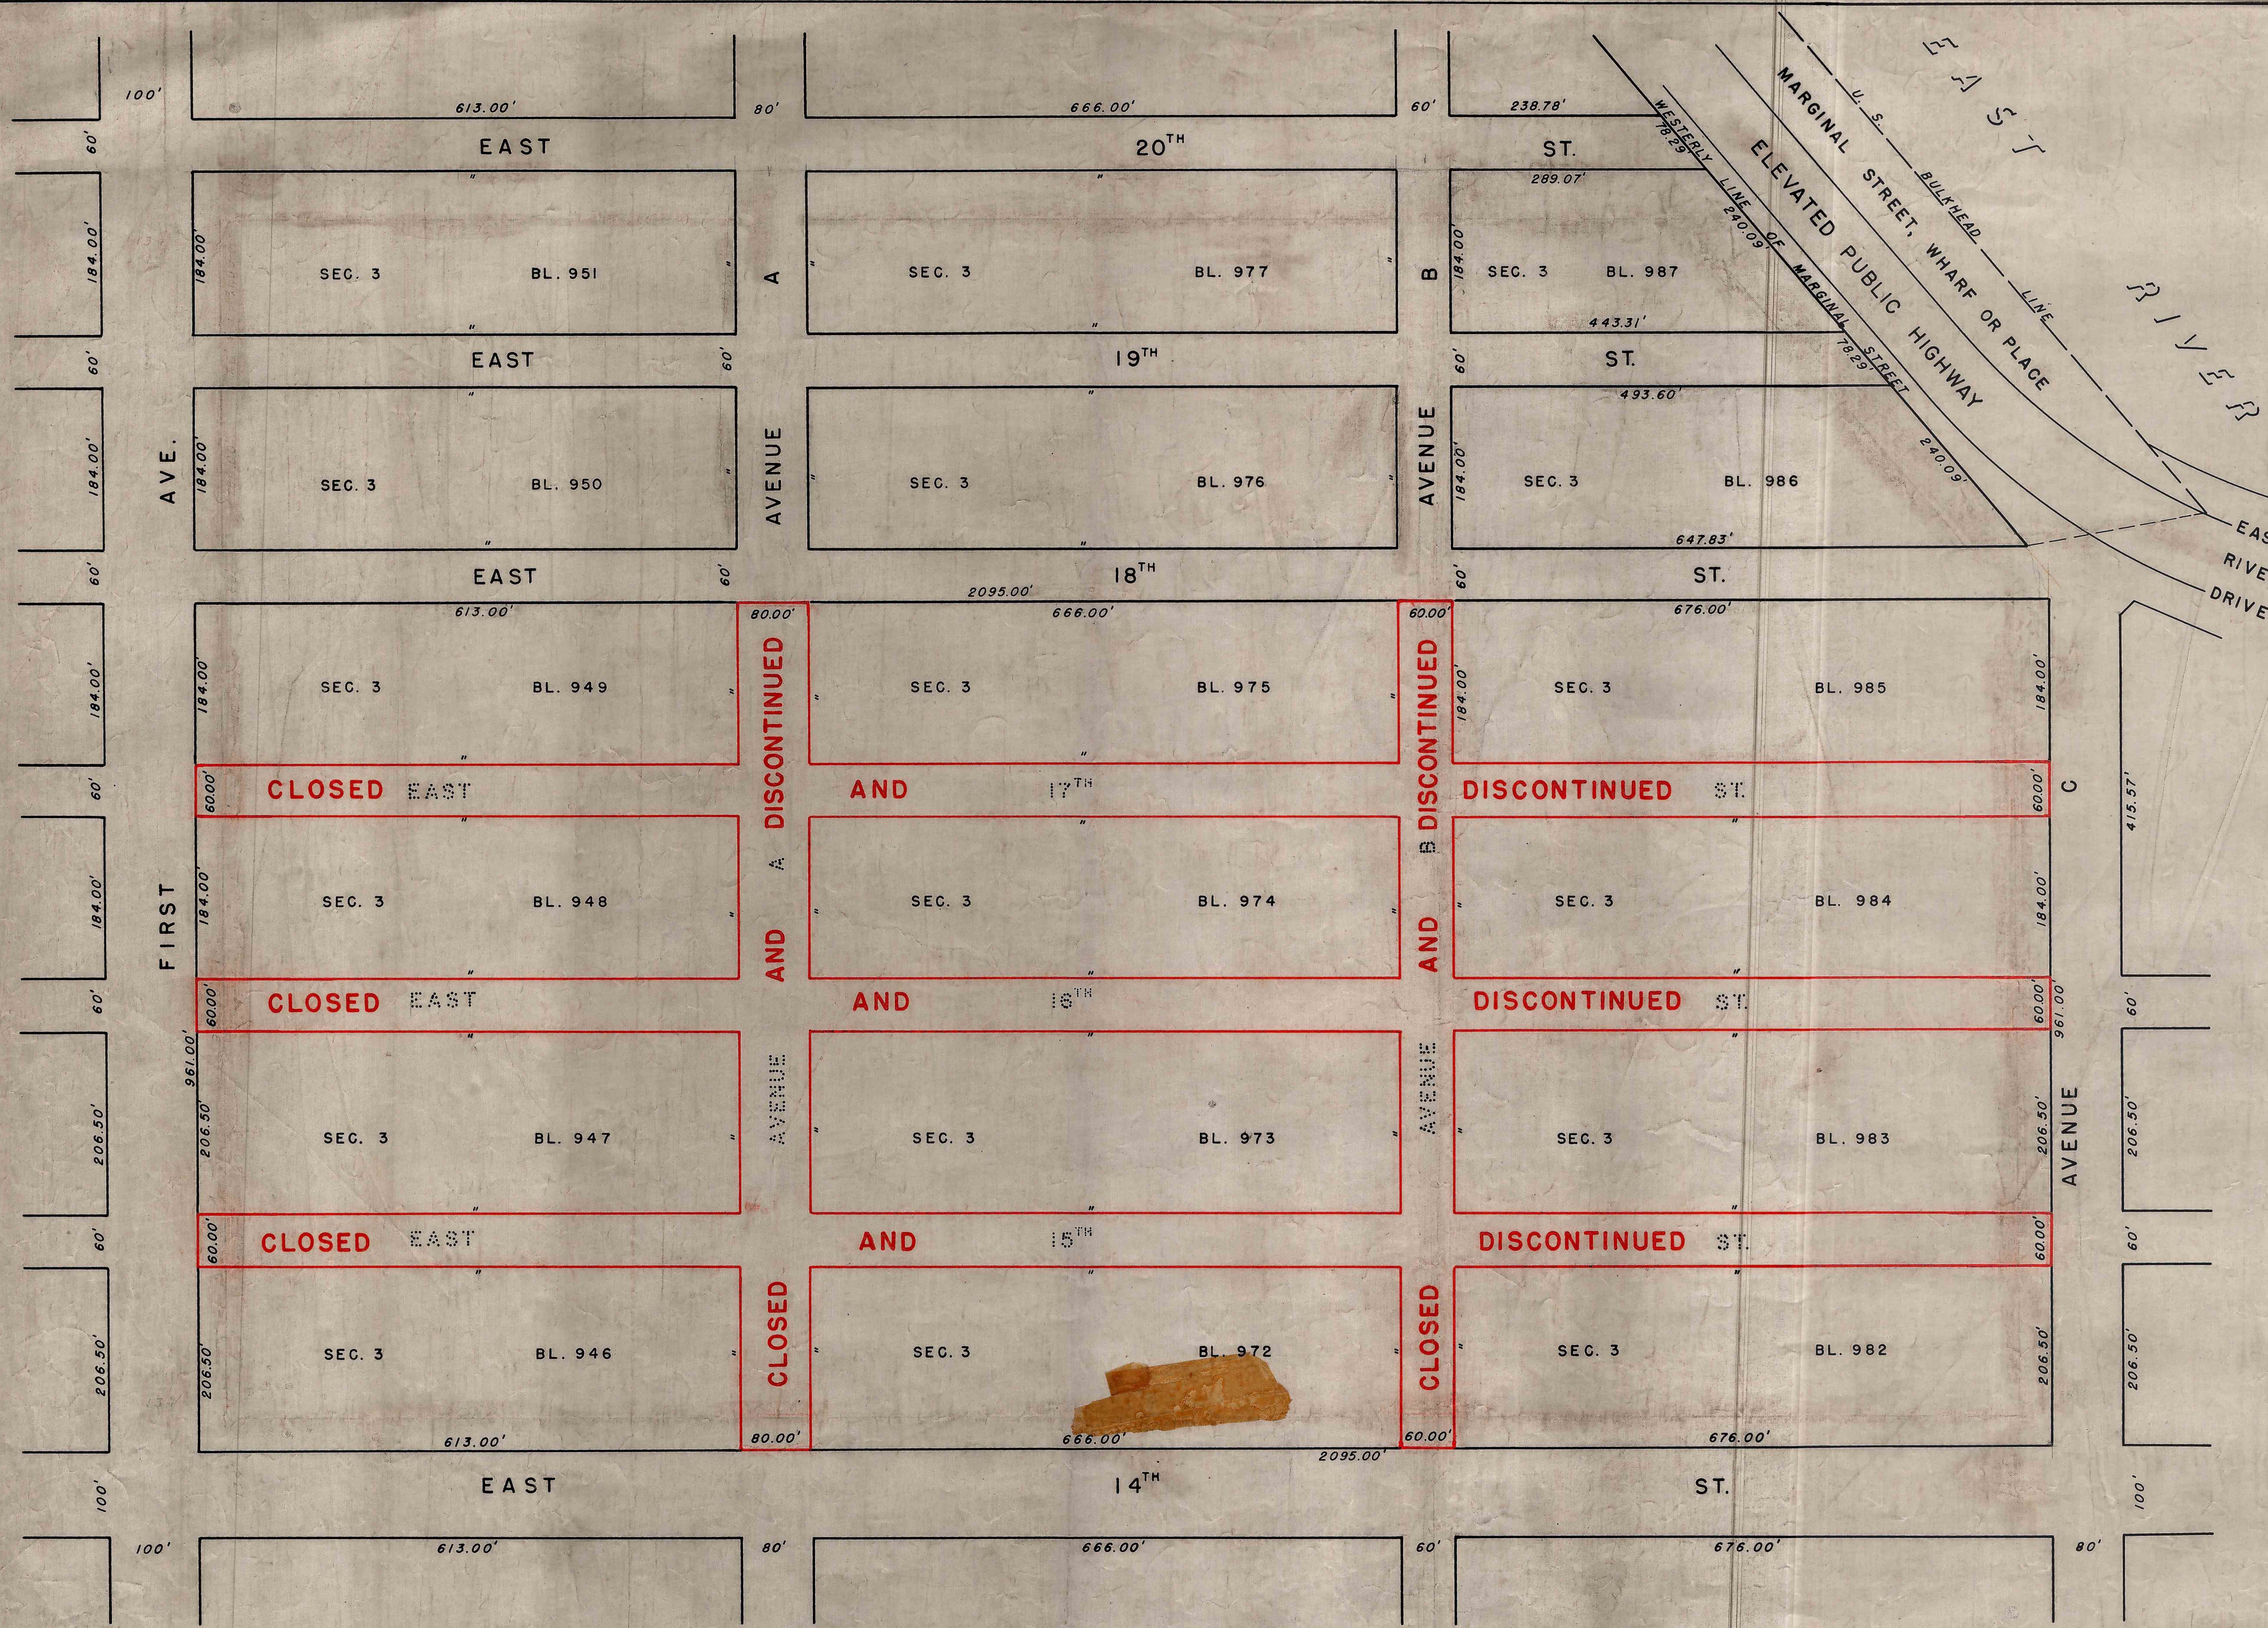

DRAWN BY *SKamp*
CHECKED BY *W.M.*
William H. Hoff
SECTION ENGINEER
L.O. Collier
ENGINEER OF DESIGN

LEGEND
STREETS TO BE CLOSED AND DISCONTINUED
ARE ENCLOSED IN SOLID RED LINES.

ACTING
ISAAC EICHHOLZ, SECRETARY OF THE BOARD
OF ESTIMATE OF THE CITY OF NEW YORK DO
HEREBY CERTIFY THAT THIS MAP IS ONE OF
FOUR SIMILAR MAPS ADOPTED BY THE SAID BOARD
OF ESTIMATE ON THE 26TH DAY OF JULY 1945
DATED: NEW YORK July 27, 1945
Isaac Eichholz
ACTING SECRETARY, BOARD OF ESTIMATE

CITY OF NEW YORK
OFFICE OF THE PRESIDENT BOROUGH OF MANHATTAN
DEPARTMENT OF BOROUGH WORKS
MAP SHOWING A CHANGE IN THE STREET SYSTEM
BY CLOSING AND DISCONTINUING
PURSUANT TO TITLE "E" OF CHAPTER 15
OF THE ADMINISTRATIVE CODE OF THE CITY OF NEW YORK
**EAST 15TH STREET,
EAST 16TH STREET, EAST 17TH STREET
BETWEEN FIRST AVENUE AND AVENUE C
AND
AVENUE A AND AVENUE B
BETWEEN EAST 14TH STREET AND EAST 18TH STREET**
DATED: MAY 4, 1945 SCALE 1"=100'

Edgar Wallman Jr.
PRESIDENT, BOROUGH OF MANHATTAN
Wm. G. Edwards
CHIEF ENGINEER
Wm. D. Singer
COMMISSIONER OF BOROUGH WORKS