


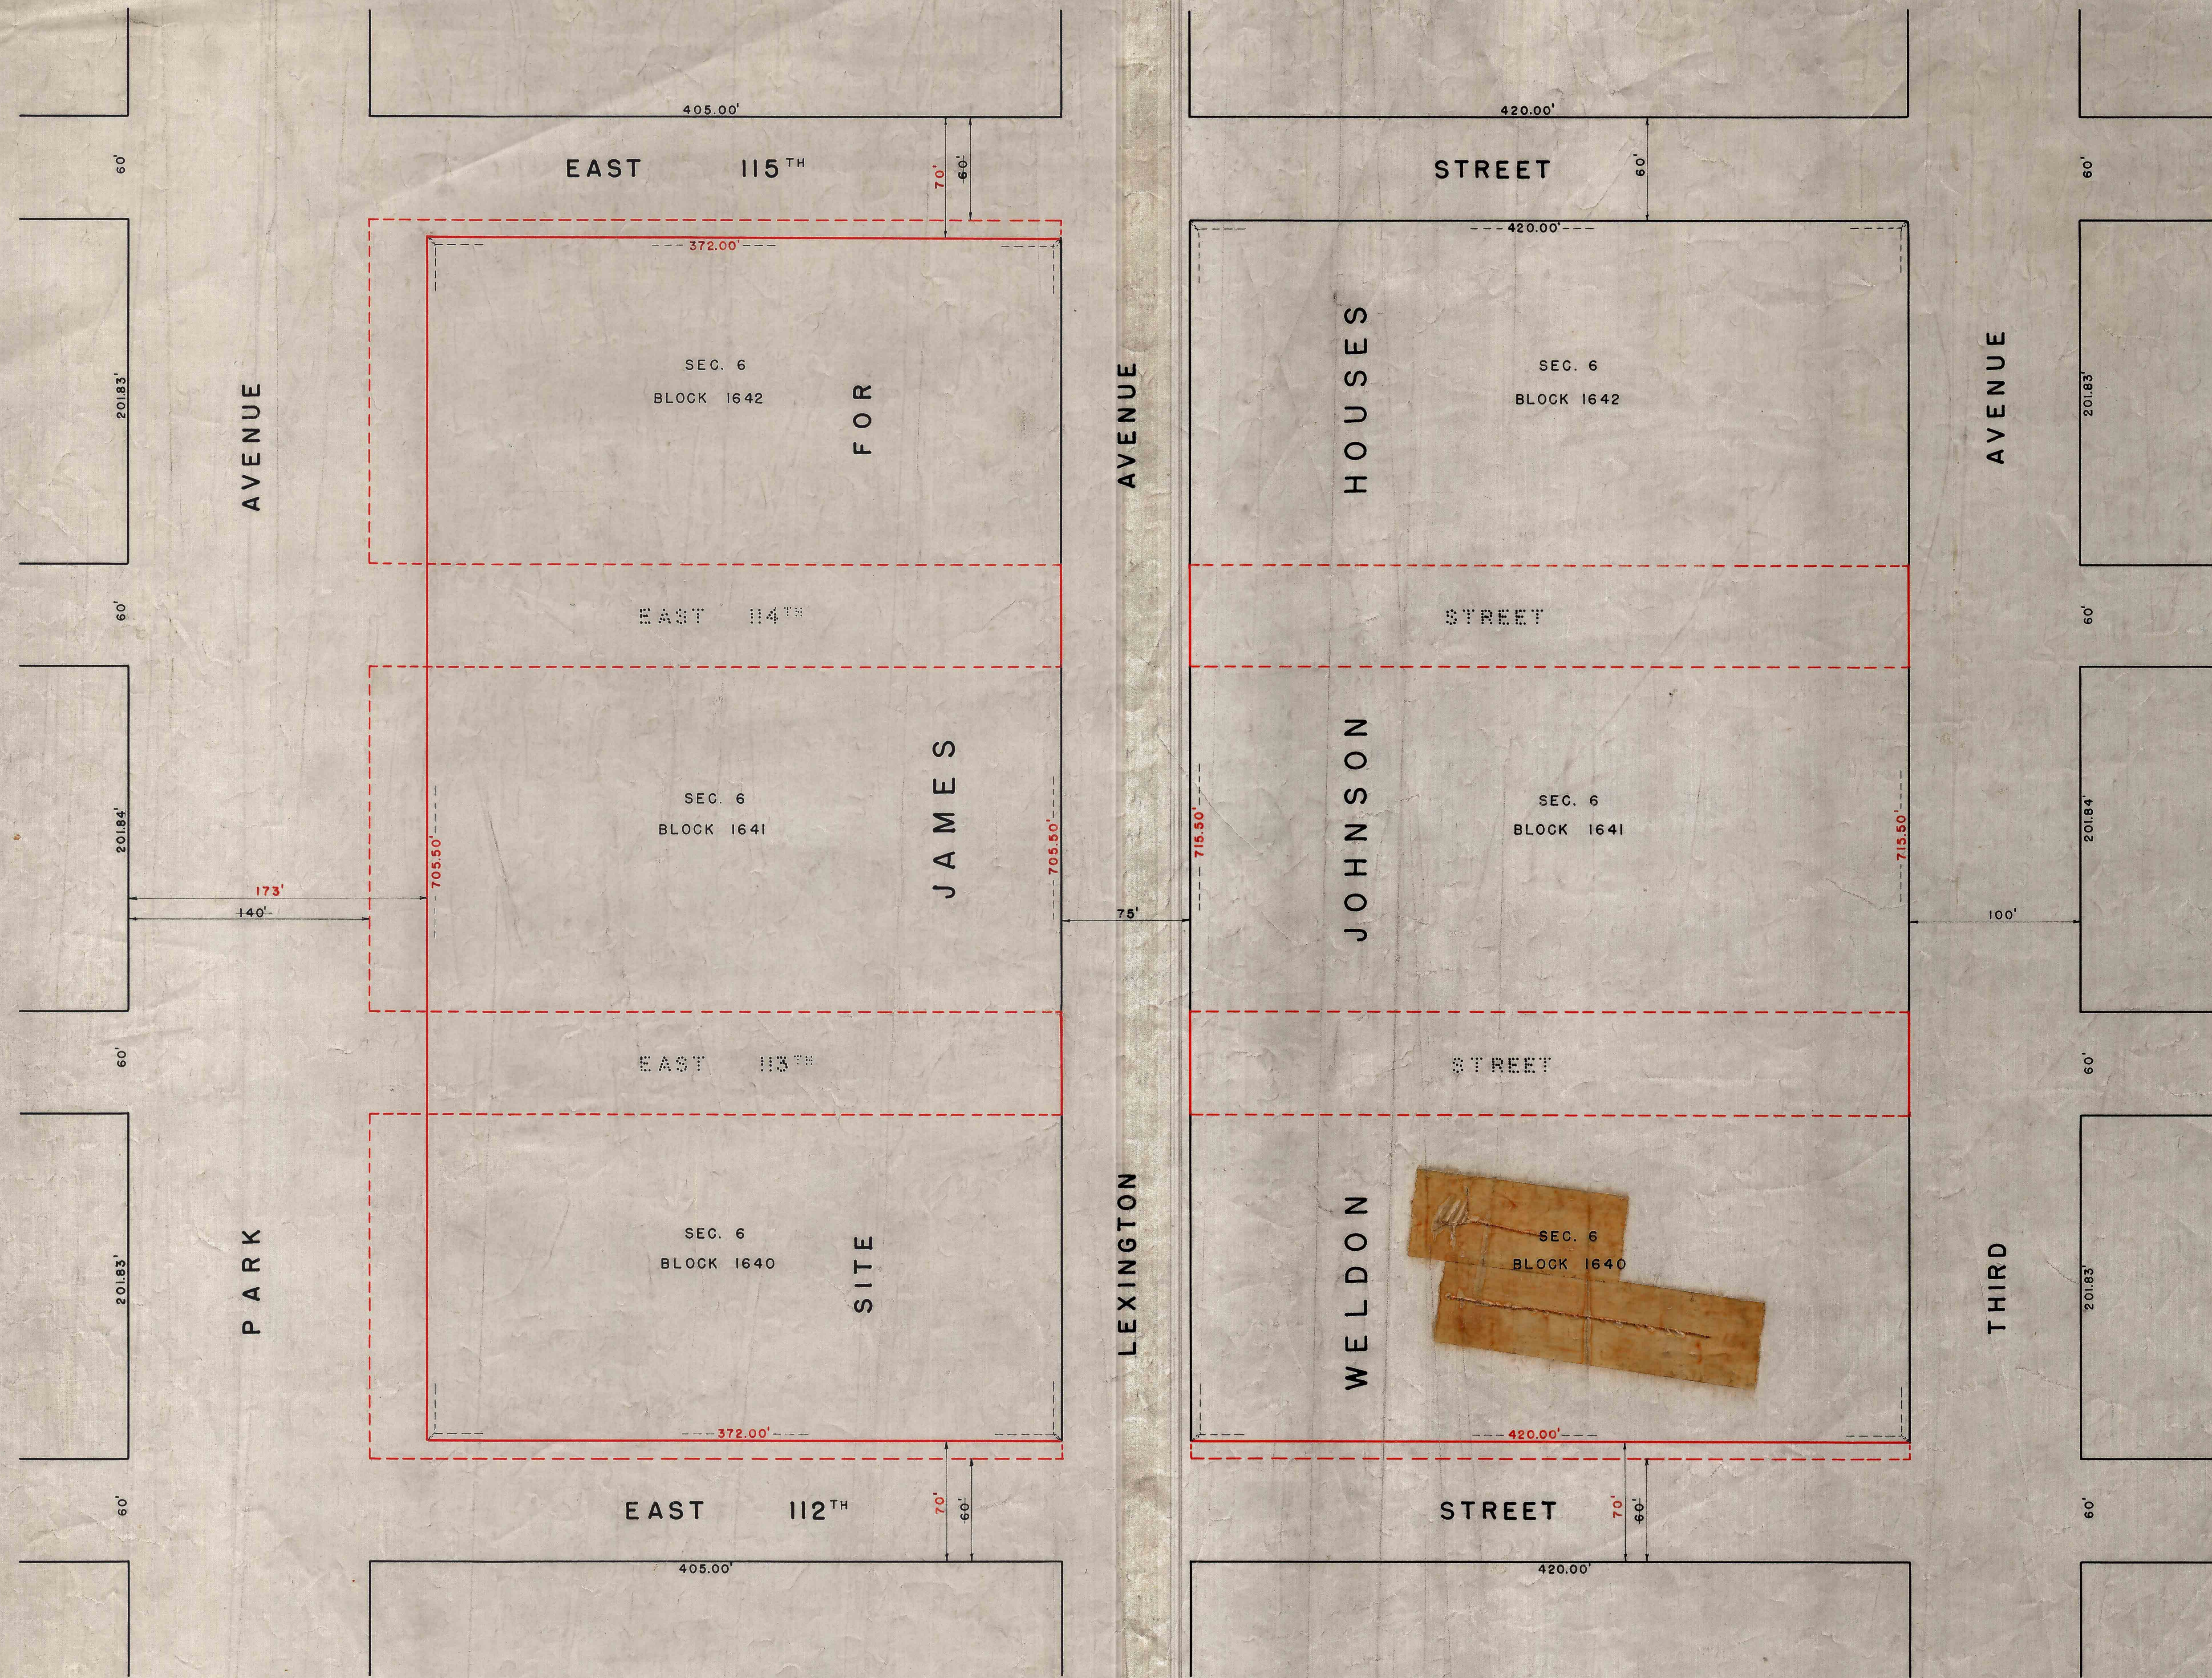

LEGEND

LINES AND DIMENSIONS PREVIOUSLY ESTABLISHED AND HEREBY RETAINED ARE SHOWN BY FULL BLACK LINES AND BLACK FIGURES. LINES AND DIMENSIONS HEREBY ESTABLISHED ARE SHOWN BY FULL RED LINES AND RED FIGURES. LINES PREVIOUSLY ESTABLISHED AND HEREBY DISCONTINUED ARE SHOWN BY DASHED RED LINES. DIMENSIONS PREVIOUSLY ESTABLISHED AND HEREBY ELIMINATED ARE SHOWN BY BLACK FIGURES CROSSED BY A BLACK LINE.

I, HILDA G. SCHWARTZ, SECRETARY OF THE BOARD OF ESTIMATE OF THE CITY OF NEW YORK DO HEREBY CERTIFY THAT THIS MAP IS ONE OF FOUR SIMILAR MAPS ADOPTED BY THE SAID BOARD OF ESTIMATE ON THE 31ST DAY OF JANUARY 1946.

DATED: NEW YORK March 25, 1946

Hilda G. Schwartz
SECRETARY BOARD OF ESTIMATE

CITY OF NEW YORK
OFFICE OF THE PRESIDENT BOROUGH OF MANHATTAN
DEPARTMENT OF BOROUGH WORKS

MAP SHOWING A CHANGE IN THE STREET SYSTEM BY ELIMINATING FROM THE CITY MAP THE LINES OF

EAST 113TH AND EAST 114TH STREETS
BETWEEN PARK AND THIRD AVENUES

BY WIDENING

EAST 112TH STREET

ALONG ITS NORTHERLY SIDE
FROM PARK AVENUE TO THIRD AVENUE

EAST 115TH STREET

ALONG ITS SOUTHERLY SIDE
FROM PARK AVENUE TO LEXINGTON AVENUE
AND

PARK AVENUE

ALONG ITS EASTERLY SIDE
FROM EAST 112TH STREET TO EAST 115TH STREET

DATED: October 16, 1945

SCALE: 1" = 50'

Edgar Woodman, Jr.
PRESIDENT BOROUGH OF MANHATTAN

Dean P. Edwards
CHIEF ENGINEER

Charles W. Williams
COMMISSIONER OF BOROUGH WORKS

DRAWN BY: H. Waksman

CHECKED BY: F. Sanchez

William D. Moffatt
SECTION ENGINEER

J. P. Collier
ENGINEER OF DESIGN

Owner 39

ACC: NO: 28678