
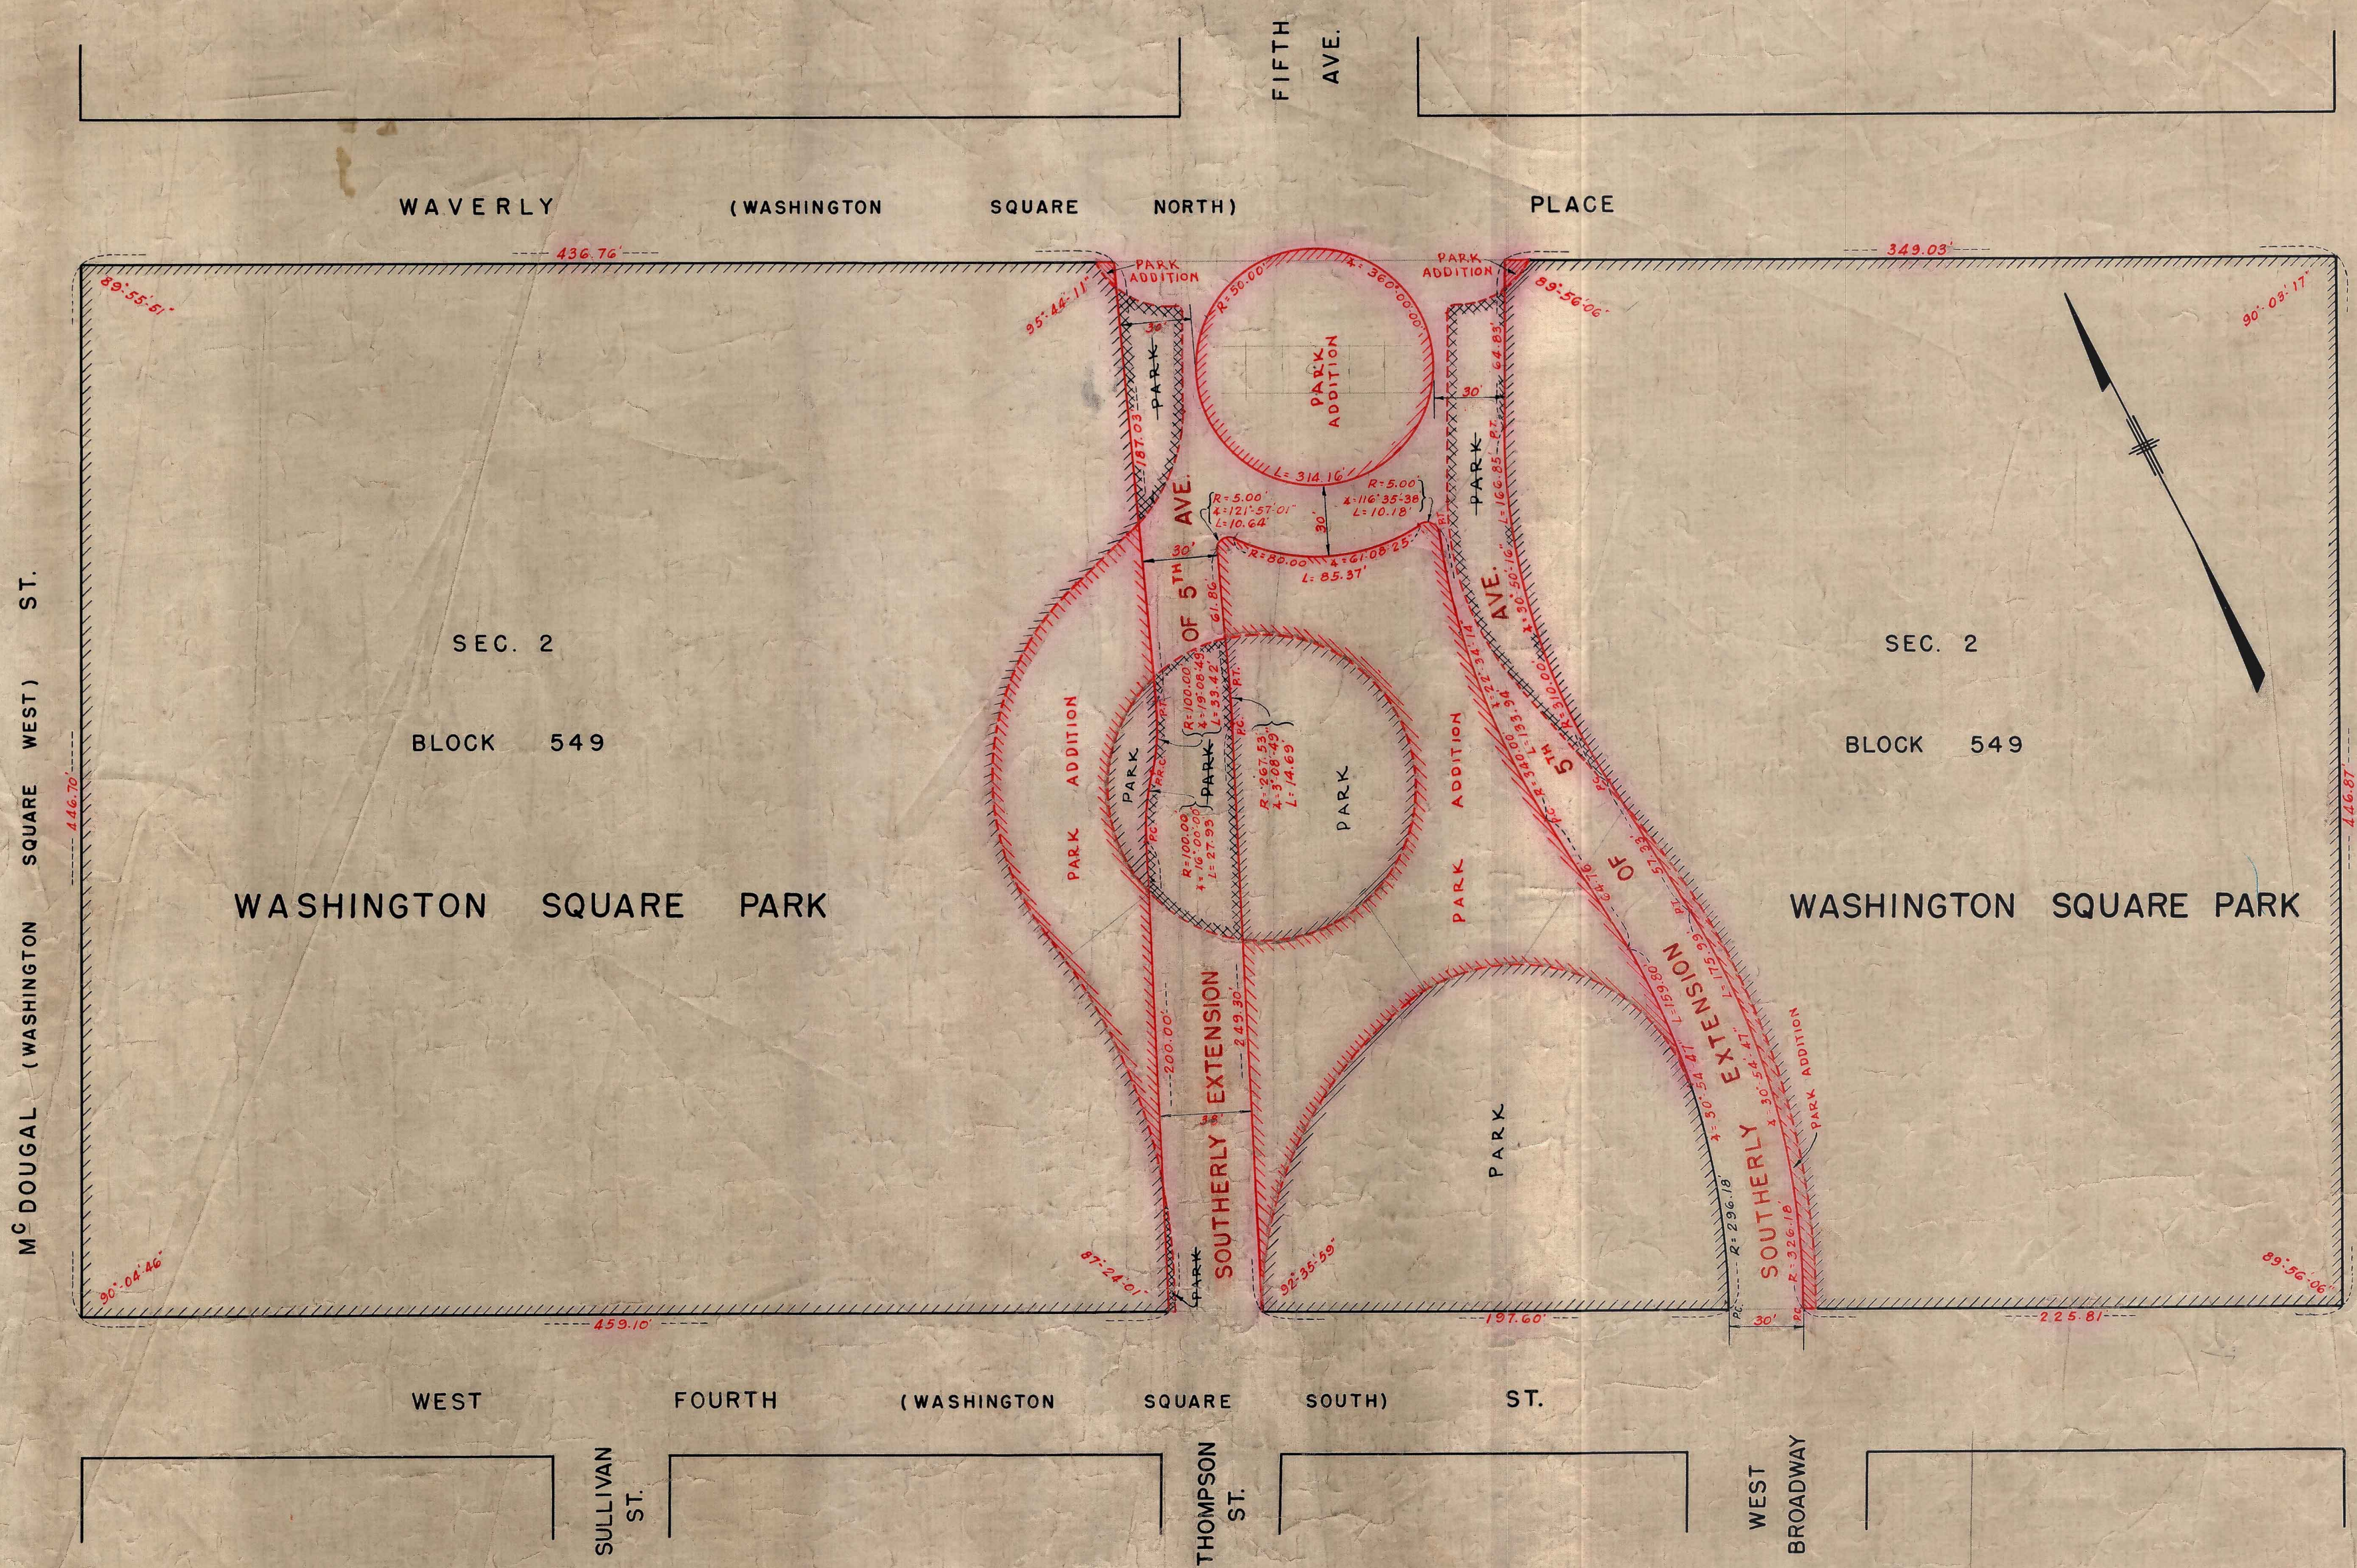


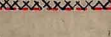

LEGEND

LINES AND DIMENSIONS PREVIOUSLY ESTABLISHED AND HEREBY RETAINED ARE SHOWN BY FULL BLACK LINES AND BLACK FIGURES.
LINES AND DIMENSIONS HEREBY ESTABLISHED ARE SHOWN BY FULL RED LINES AND RED FIGURES.
LINES PREVIOUSLY ESTABLISHED AND HEREBY DISCONTINUED ARE SHOWN BY DASHED RED LINES.
PARK PREVIOUSLY ESTABLISHED SHOWN THUS 
PARK HEREBY ESTABLISHED SHOWN THUS 
PARK AREA HEREBY ELIMINATED SHOWN THUS 

I, HILDA G. SCHWARTZ, SECRETARY OF THE BOARD OF ESTIMATE OF THE CITY OF NEW YORK DO HEREBY CERTIFY THAT THIS MAP IS ONE OF FIVE SIMILAR MAPS ADOPTED BY THE SAID BOARD OF ESTIMATE ON THE 17th DAY OF JUNE 1947.

DATED: NEW YORK September 28, 1947

Hilda G. Schwartz
SECRETARY, BOARD OF ESTIMATE

CITY OF NEW YORK
OFFICE OF THE PRESIDENT BOROUGH OF MANHATTAN
DEPARTMENT OF BOROUGH WORKS
MAP SHOWING A CHANGE IN THE CITY MAP
BY CHANGING THE LINES OF THE SOUTHERLY EXTENSION OF
FIFTH AVENUE
AND THE LINES OF WASHINGTON SQUARE PARK
ADJACENT THERETO
BETWEEN
WAVERLY PLACE AND WEST 4TH ST.
AND BY ADJUSTING THE DIMENSIONS OF THE BOUNDING BLOCK
DATED: SEPT. 9, 1947
SCALE 1" = 40'

DRAWN BY *W. H. H. H.*
CHECKED BY *L. L. L.*

William H. H. H.
SECTION ENGINEER
R. H. H. H.
Asst. ENGINEER OF DESIGN

Michael Lee
CHIEF ENGINEER

Hugo E. Rogers
PRESIDENT, BOROUGH OF MANHATTAN

R. F. H. H.
CHIEF ENGINEER OF DESIGN

ACC: No: 28923