
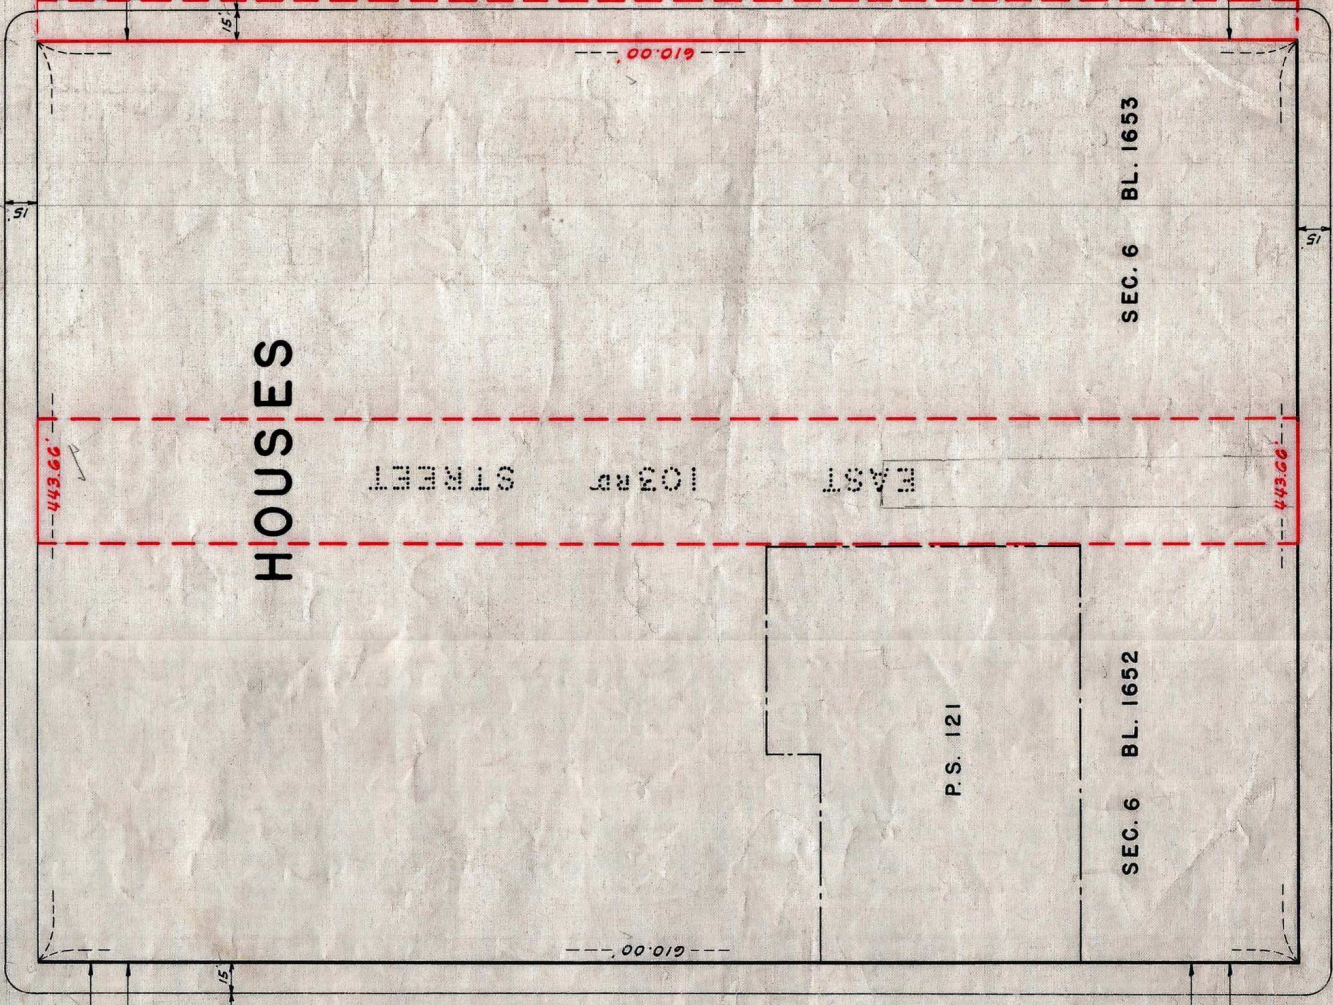
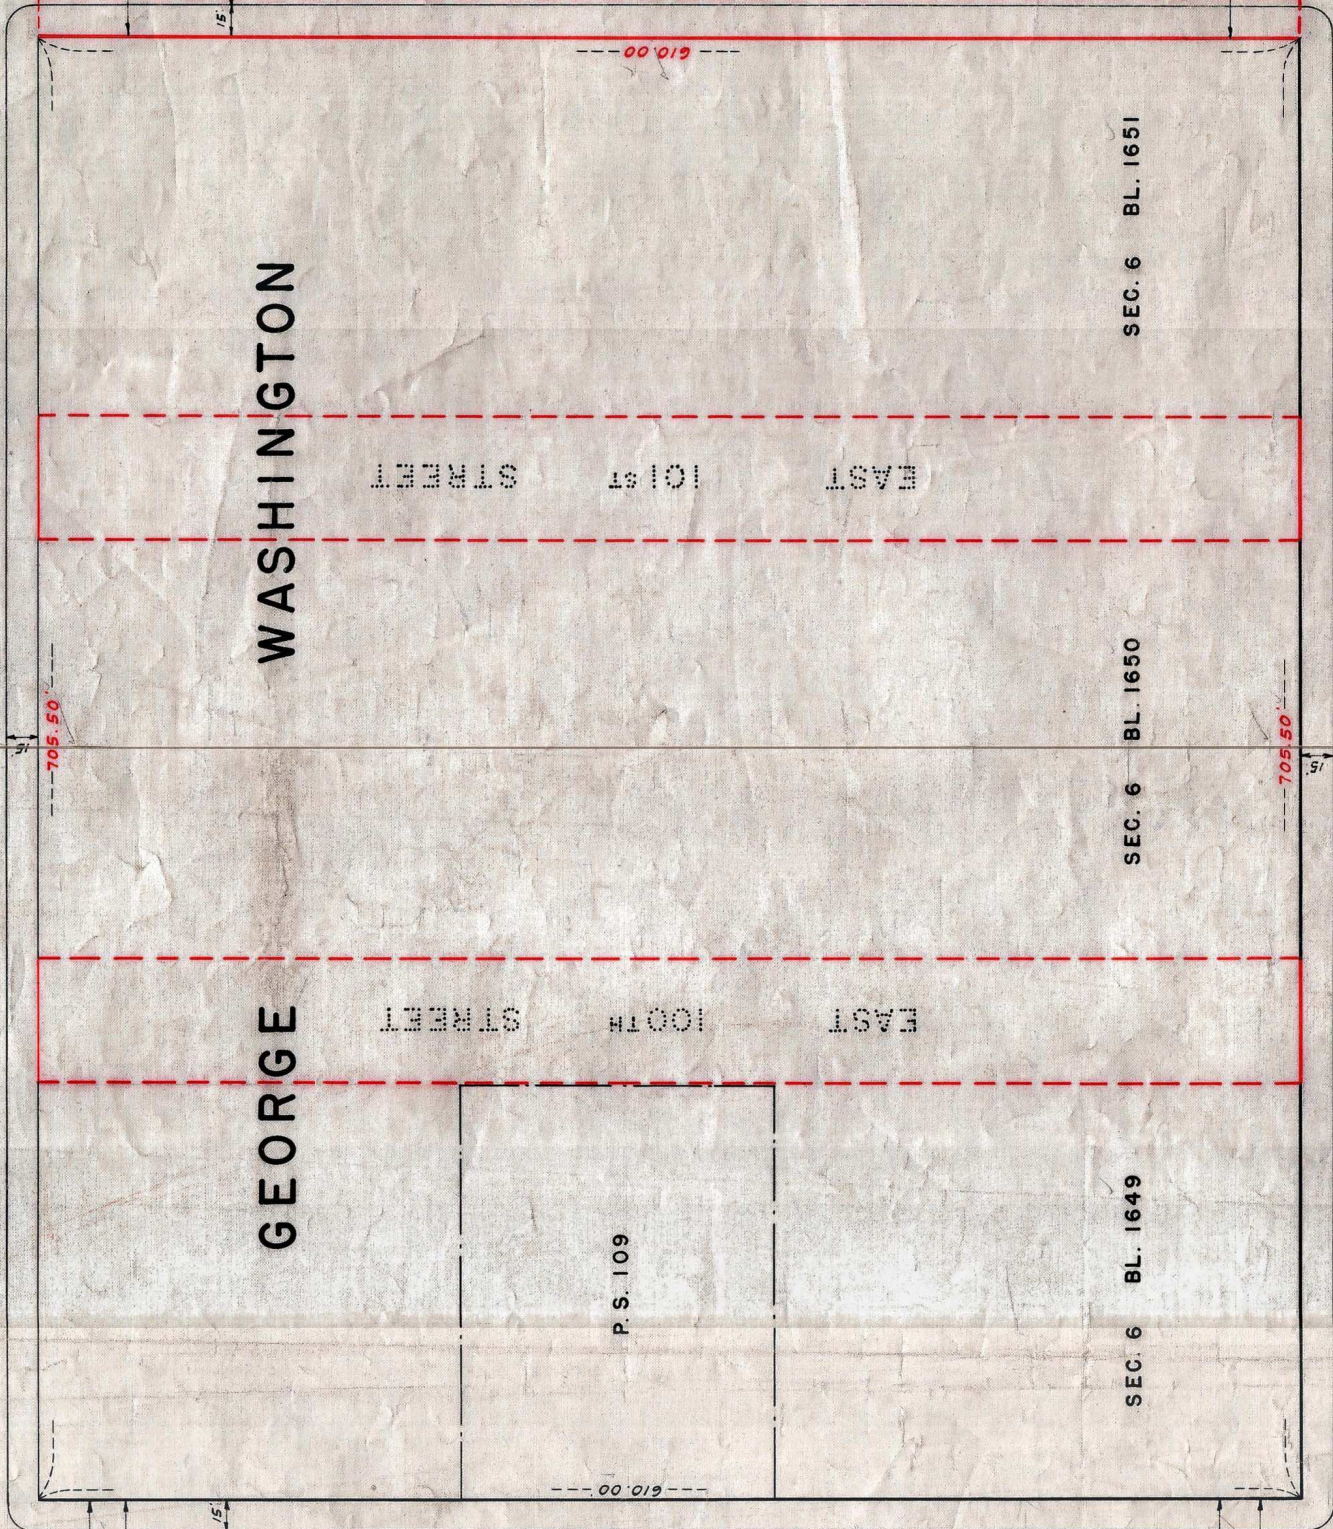



THIRD

AVENUE

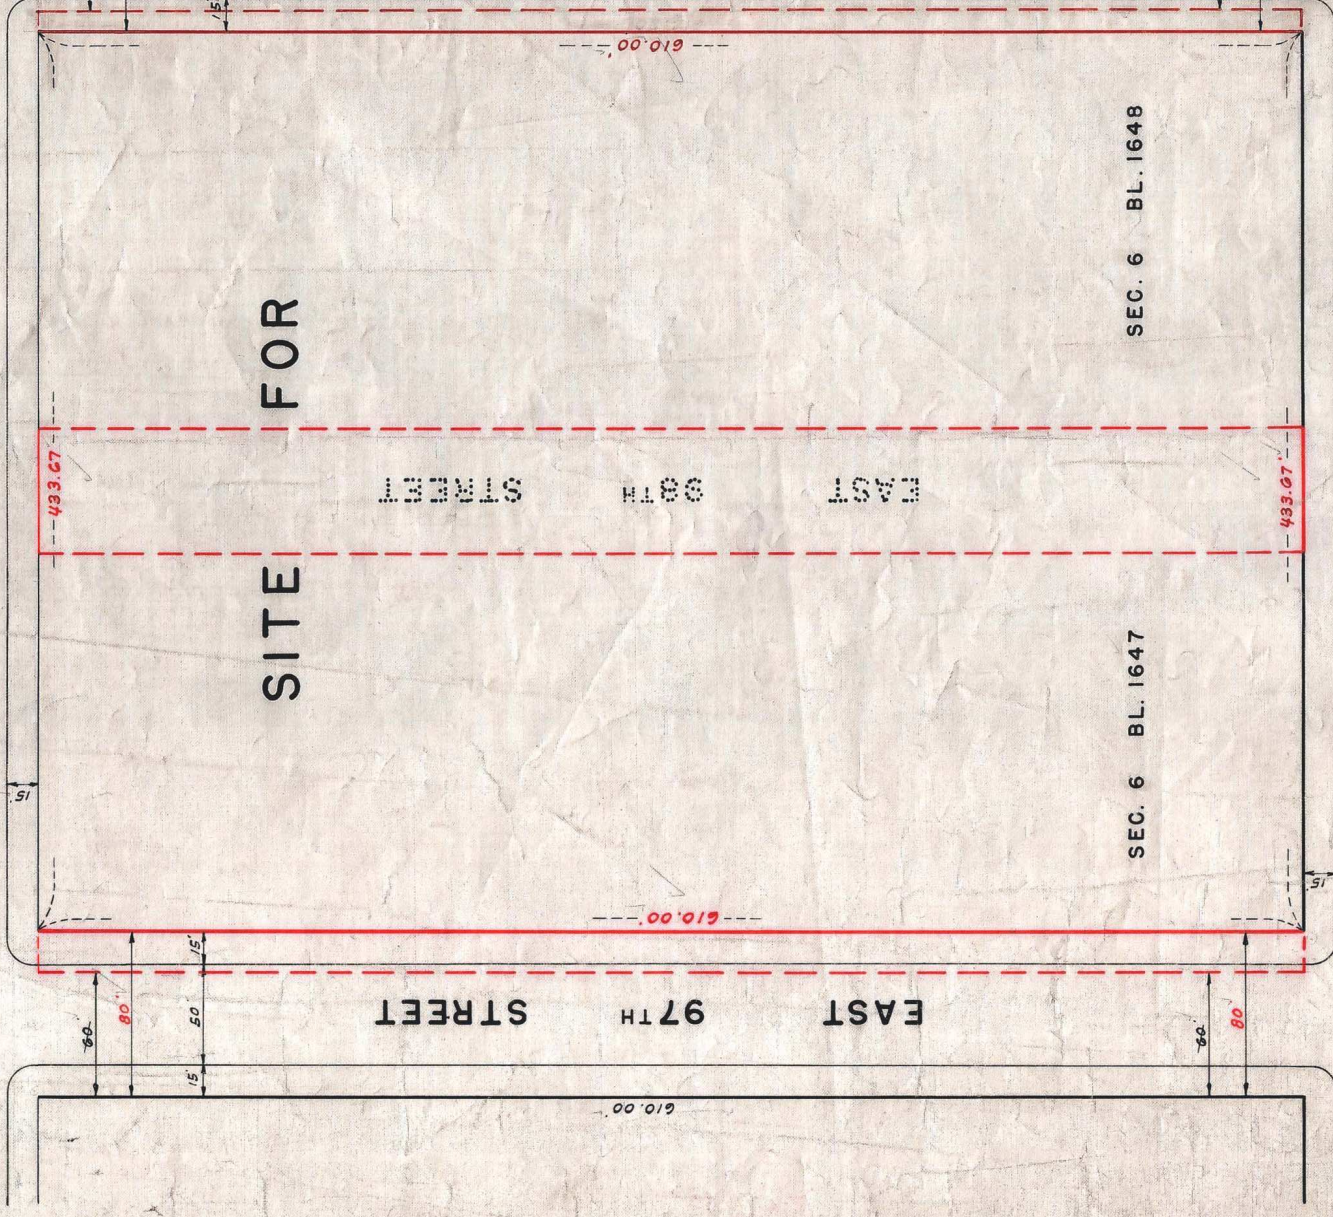

SECOND

AVENUE

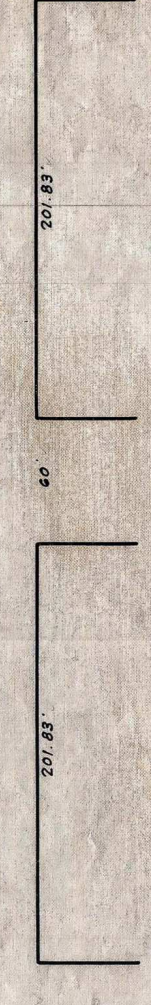

L. RUTH W. WHALEY, SECRETARY OF THE
BOARD OF ESTIMATE OF THE CITY OF NEW YORK
DO HEREBY CERTIFY THAT THIS MAP IS ONE OF
FIVE SIMILAR MAPS ADOPTED BY THE SAID BOARD
OF ESTIMATE ON THE 22ND DAY OF JANUARY, 1952
DATED: NEW YORK April 21 1952
Ruth W. Whaley
SECRETARY BOARD OF ESTIMATE

CITY OF NEW YORK
OFFICE OF THE PRESIDENT BOROUGH OF MANHATTAN
DEPARTMENT OF BOROUGH WORKS
MAP SHOWING A CHANGE IN THE STREET SYSTEM
BY WIDENING
BETWEEN
E. 97TH ST., E. 99TH ST., E. 102ND ST. AND E. 104TH ST.
SECOND AVENUE AND THIRD AVENUE
AND BY ELIMINATING THE LINES OF
E. 98TH ST., E. 100TH ST., E. 101ST ST. AND E. 103RD ST.
BETWEEN
SECOND AVENUE AND THIRD AVENUE

NOTES

LINES AND DIMENSIONS PREVIOUSLY ESTABLISHED AND HEREBY RETAINED
ARE SHOWN BY FULL BLACK LINES AND BLACK FIGURES.
LINES AND DIMENSIONS HEREBY ESTABLISHED ARE SHOWN BY FULL RED
LINES AND RED FIGURES.
LINES PREVIOUSLY ESTABLISHED AND HEREBY DISCONTINUED ARE SHOWN
BY DASHED RED LINES.
DIMENSIONS PREVIOUSLY ESTABLISHED AND HEREBY DISCONTINUED
ARE SHOWN BY BLACK FIGURES CROSSED BY A BLACK LINE.

DATED: JUNE 28, 1950

SCALE 1" = 60'

DRAWN BY: Sanchez

CHECKED BY: E.K.

Edward J. Karp
SECTION ENGINEER

Robert F. Whaley
ENGINEER OF DESIGN

Robert F. Whaley
PRESIDENT, BOROUGH OF MANHATTAN

H.W. Key
ACT. CHIEF ENGINEER