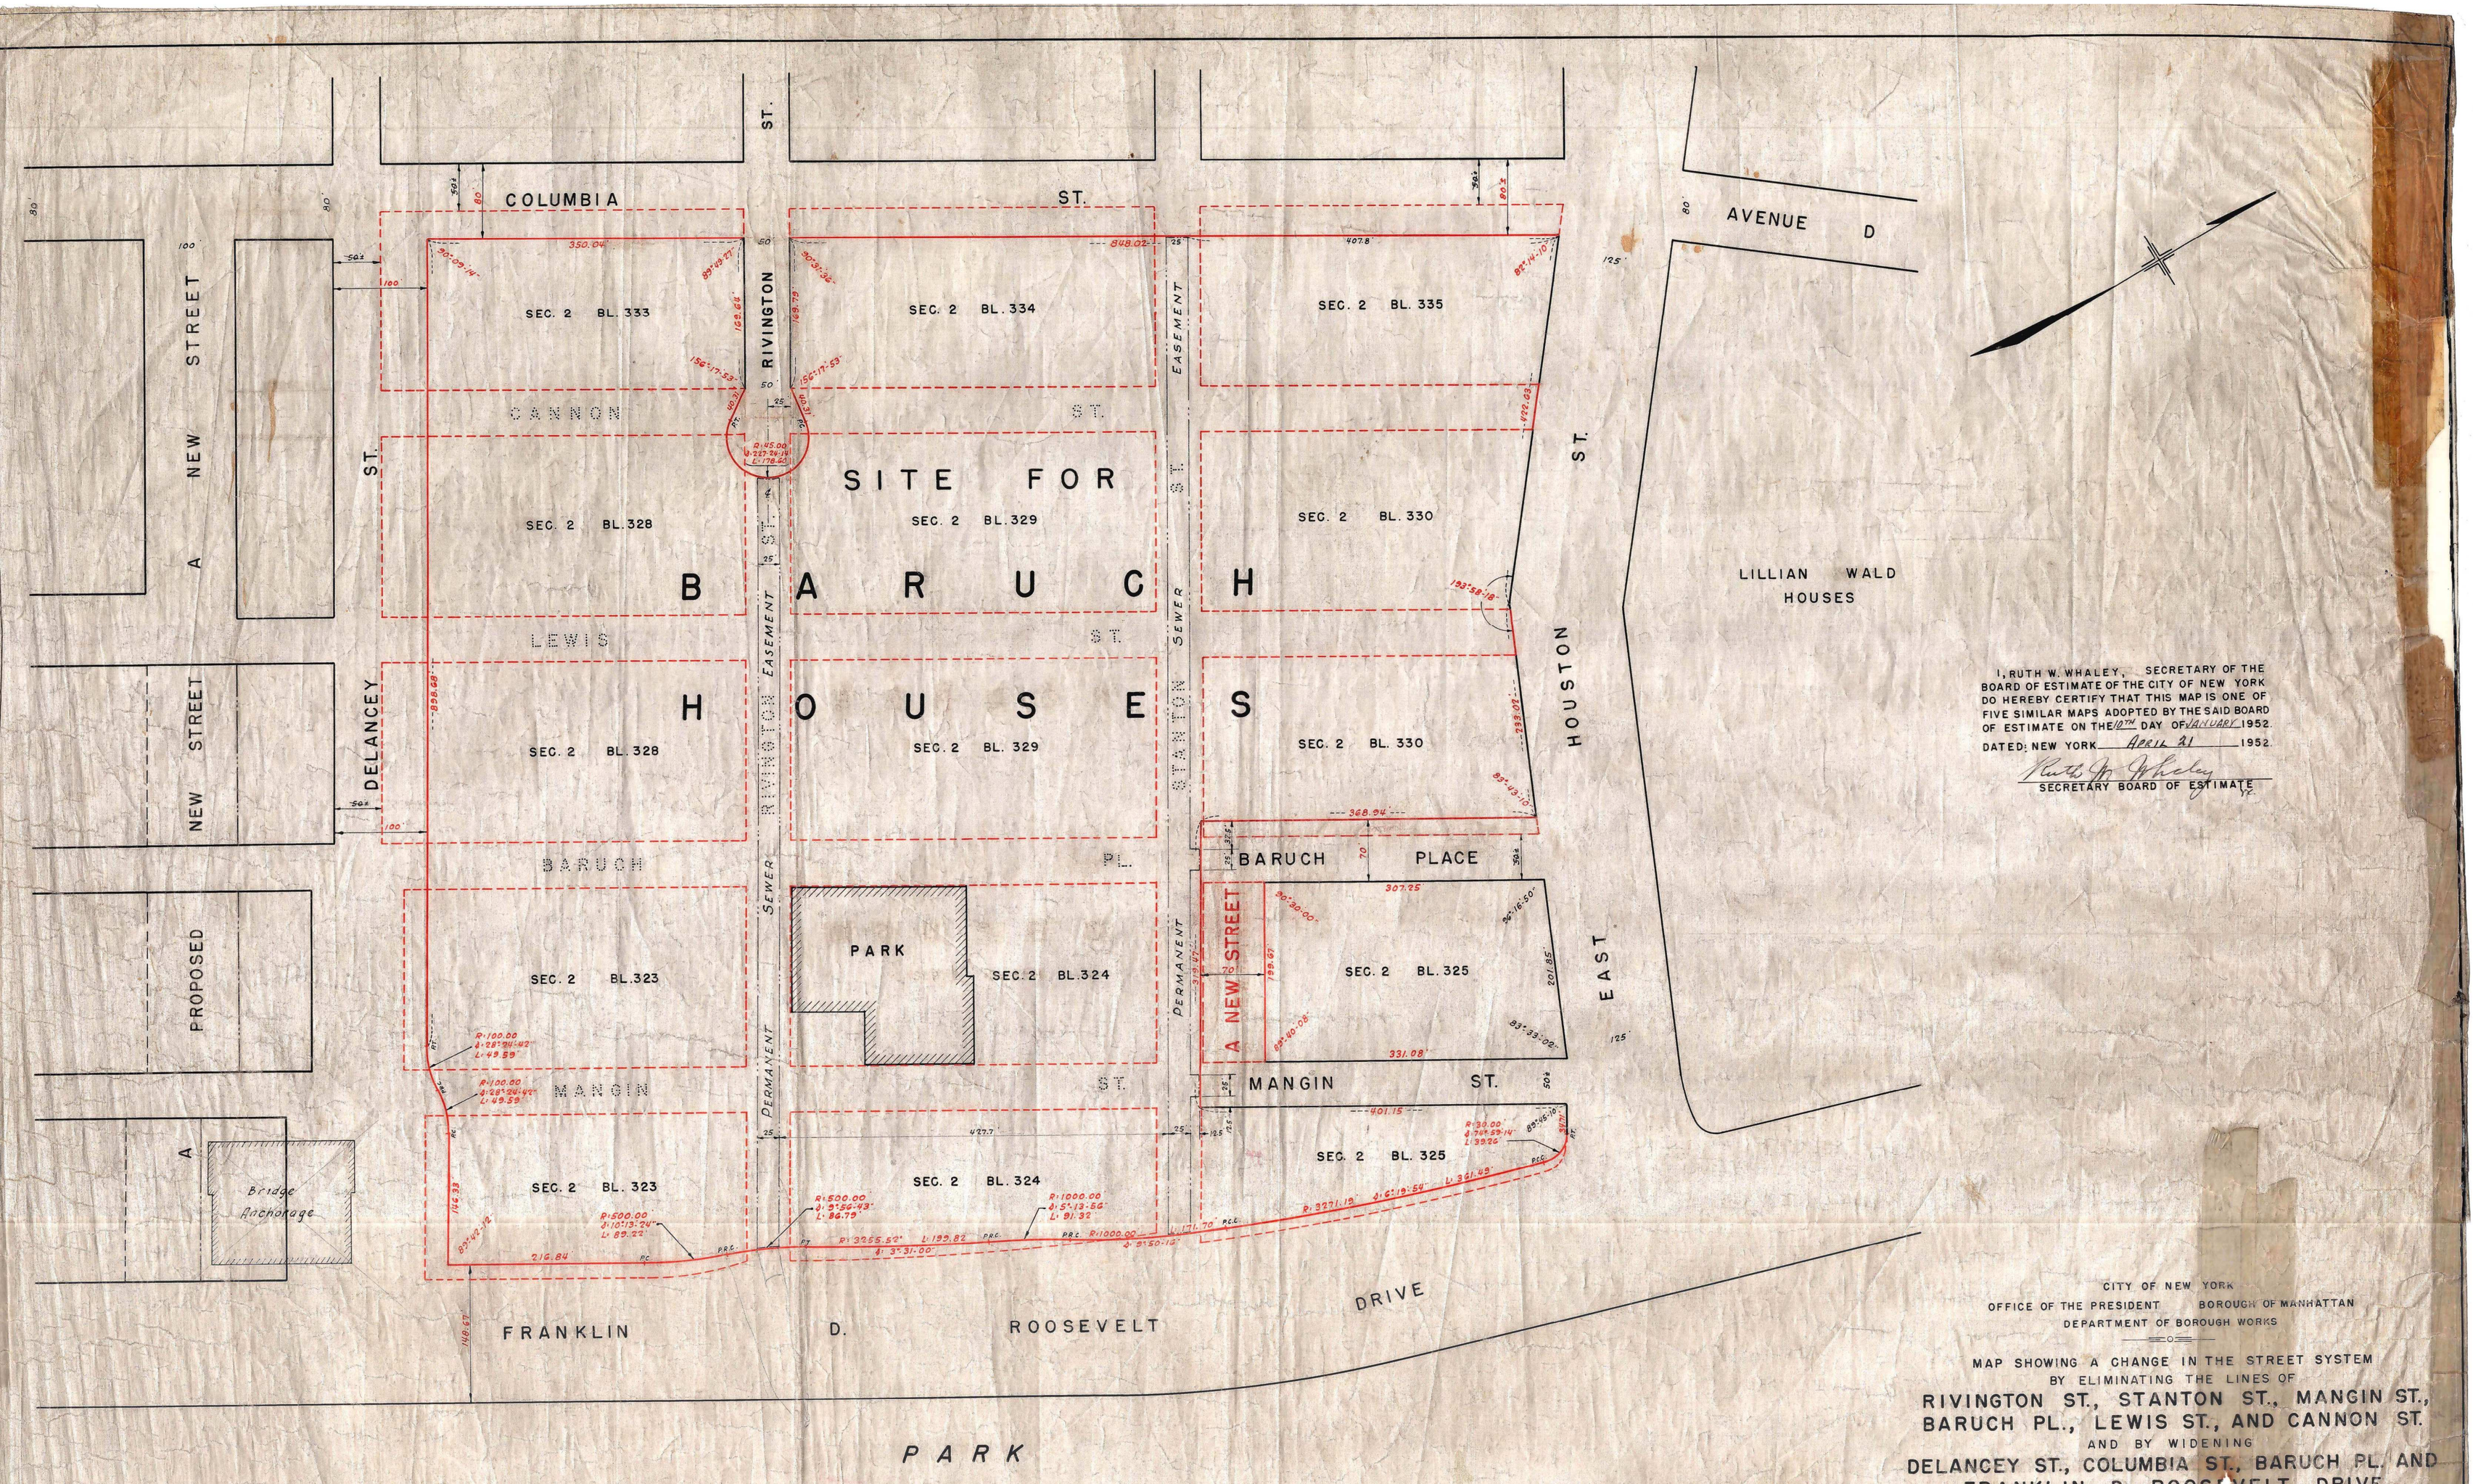

I, RUTH W. WHALEY, SECRETARY OF THE BOARD OF ESTIMATE OF THE CITY OF NEW YORK DO HEREBY CERTIFY THAT THIS MAP IS ONE OF FIVE SIMILAR MAPS ADOPTED BY THE SAID BOARD OF ESTIMATE ON THE 10TH DAY OF JANUARY 1952.

DATED: NEW YORK APRIL 21 1952.

Ruth W. Whaley
SECRETARY BOARD OF ESTIMATE

CITY OF NEW YORK
OFFICE OF THE PRESIDENT BOROUGH OF MANHATTAN
DEPARTMENT OF BOROUGH WORKS

MAP SHOWING A CHANGE IN THE STREET SYSTEM
BY ELIMINATING THE LINES OF
RIVINGTON ST., STANTON ST., MANGIN ST., BARUCH PL., LEWIS ST., AND CANNON ST.
AND BY WIDENING
DELANCEY ST., COLUMBIA ST., BARUCH PL. AND FRANKLIN D. ROOSEVELT DRIVE
IN THE AREA BOUNDED BY
DELANCEY ST., COLUMBIA ST., EAST HOUSTON ST. AND FRANKLIN D. ROOSEVELT DRIVE.
AND BY LAYING OUT
A NEW STREET
BETWEEN BARUCH PL. AND MANGIN ST.

DATED: MARCH 8, 1951 SCALE 1"=80'

NOTES

LINES AND DIMENSIONS PREVIOUSLY ESTABLISHED AND HEREBY RETAINED ARE SHOWN BY FULL BLACK LINES AND BLACK FIGURES.

LINES AND DIMENSIONS HEREBY ESTABLISHED ARE SHOWN BY FULL RED LINES AND RED FIGURES.

LINES PREVIOUSLY ESTABLISHED AND HEREBY DISCONTINUED ARE SHOWN BY DASHED RED LINES.

DIMENSIONS PREVIOUSLY ESTABLISHED AND HEREBY ELIMINATED ARE SHOWN BY BLACK FIGURES CROSSED BY A BLACK LINE.

PARK PREVIOUSLY ESTABLISHED SHOWN THUS ..... PARK

LINES AND DIMENSIONS OF EASEMENT TO BE RETAINED BY THE CITY FOR SEWER SERVICES ARE SHOWN THUS 25

DRAWN BY: E.I.K. & F.S.
CHECKED BY: E.K.
SECTION ENGINEER
J. A. Collyer
ENGINEER OF DESIGN

Robert F. Wagner Jr.
PRESIDENT, BOROUGH OF MANHATTAN

Anthony J. Denargo
CHIEF ENGINEER

ACC. NO. #29173

Drawer 39

Acc # 29173 Filed in the Office of the Borough President Manhattan 4/30/52 [illegible]

ACC. No. 29173