


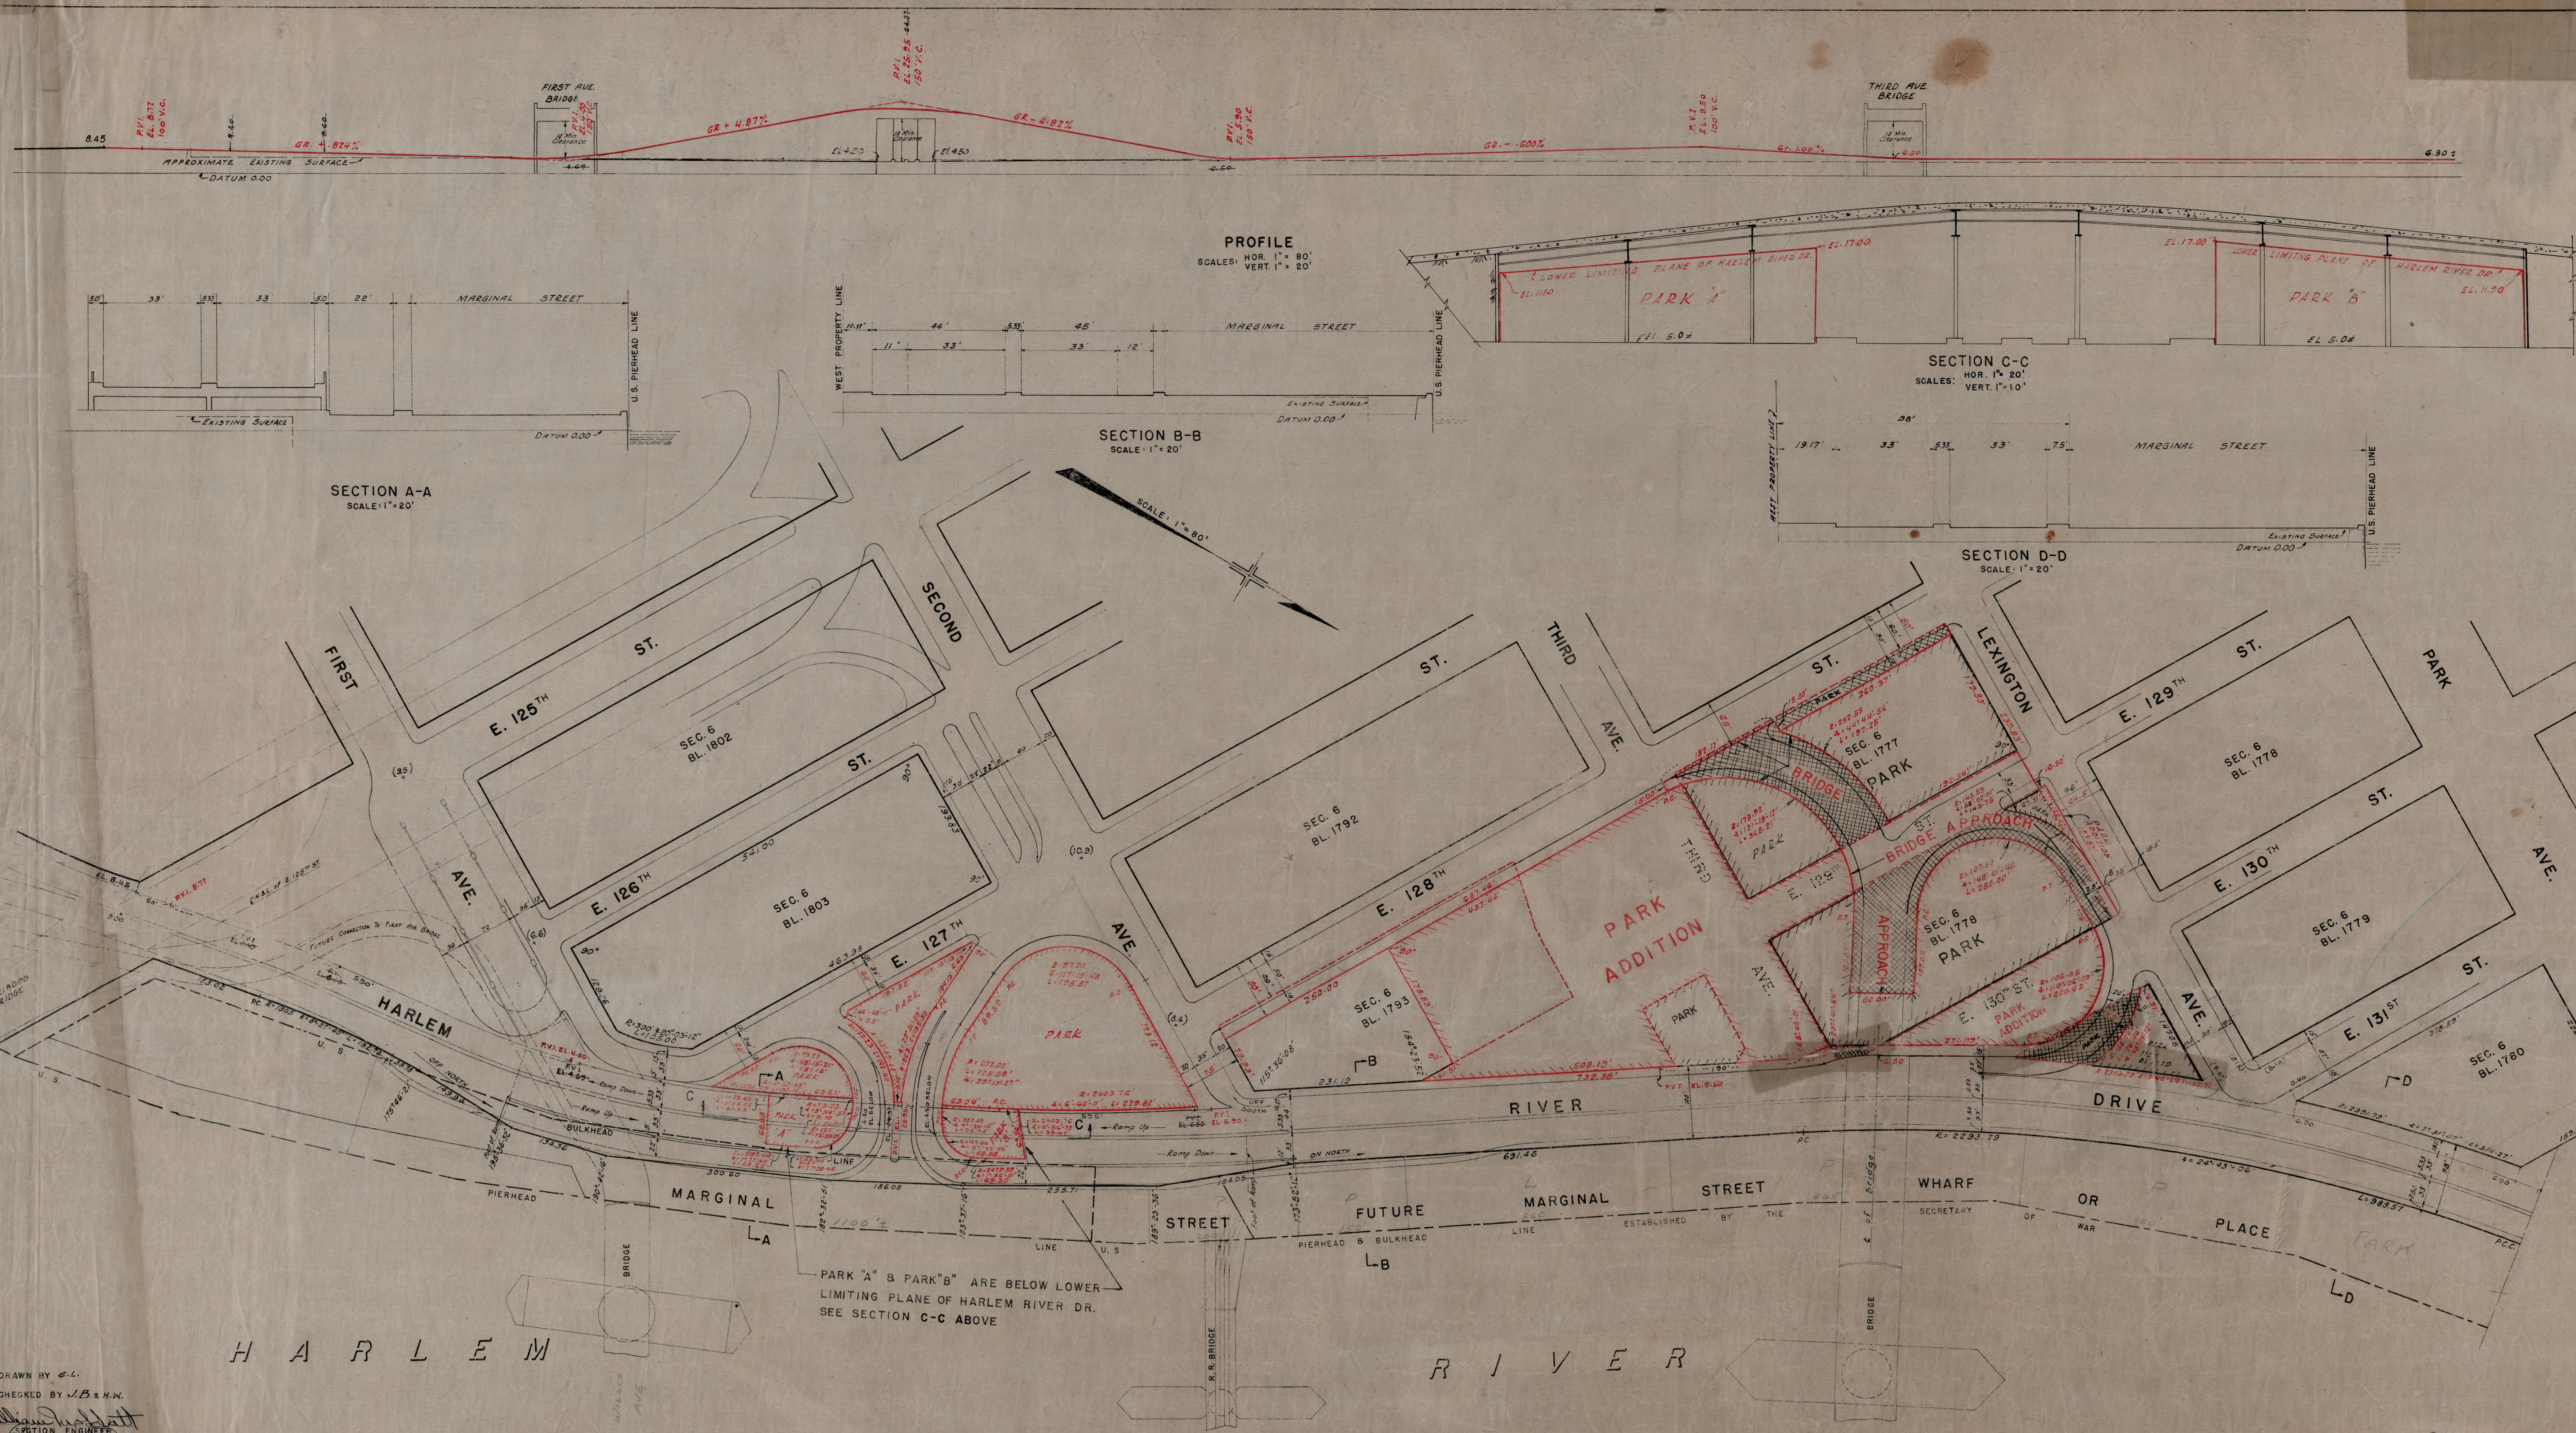

NOTES

1. LINES AND DIMENSIONS PREVIOUSLY ESTABLISHED AND HEREBY RETAINED ARE SHOWN BY FULL BLACK LINES AND BLACK FIGURES.
2. LINES AND DIMENSIONS HEREBY ESTABLISHED ARE SHOWN BY FULL RED LINES AND RED FIGURES.
3. LINES HEREBY DISCONTINUED ARE SHOWN BY DASHED RED LINES.
4. GRADES HEREBY ESTABLISHED ARE SHOWN BY VERTICAL RED FIGURES.
5. GRADES PREVIOUSLY ESTABLISHED AND HEREBY RETAINED ARE SHOWN BY VERTICAL BLACK FIGURES.
6. GRADES PREVIOUSLY ESTABLISHED AND HEREBY ABOLISHED ARE SHOWN BY VERTICAL BLACK FIGURES CROSSED BY A BLACK LINE.
7. ELEVATIONS SHOWN ON THIS MAP ARE FOR TOP OF CURB AND ARE REFERRED TO THE BOROUGH WORKS DATUM OF THE BOROUGH OF MANHATTAN, WHICH IS 2.75 FEET ABOVE MEAN SEA LEVEL AT SANDY HOOK.
8. EXISTING SURFACE ELEVATIONS ARE SHOWN BY VERTICAL BLACK FIGURES ENCLOSED IN PARENTHESES.
9. PARKS HEREBY ESTABLISHED ARE SHOWN THUS .
10. PORTION OF PARK HEREBY ELIMINATED SHOWN THUS .
11. PARKS PREVIOUSLY ESTABLISHED SHOWN THUS

I, RUTH W. WHALEY, SECRETARY OF THE BOARD OF ESTIMATE OF THE CITY OF NEW YORK DO HEREBY CERTIFY THAT THIS MAP IS ONE OF FIVE SIMILAR MAPS ADOPTED BY THE SAID BOARD OF ESTIMATE ON THE 13th DAY OF June 1955
DATED: NEW YORK August 23, 1955
Ruth W. Whaley
SECRETARY BOARD OF ESTIMATE

CITY OF NEW YORK
OFFICE OF THE PRESIDENT, BOROUGH OF MANHATTAN
DEPARTMENT OF BOROUGH WORKS
MAP SHOWING A CHANGE IN THE CITY MAP WITHIN THE AREA BOUNDED BY EAST 125th STREET, SECOND AVENUE, EAST 128th STREET, LEXINGTON AVENUE AND THE HARLEM RIVER
BY
CHANGING THE LINES AND GRADES OF THE STREET SYSTEM
BY
LAYING OUT AN APPROACH TO THE THIRD AVENUE BRIDGE
AND BY
ELIMINATING PORTIONS OF AND LAYING OUT PARKS AND PARK ADDITIONS
DATED: FEB 11, 1954
John T. Carroll
PRESIDENT BOROUGH OF MANHATTAN
William J. ...
COMMISSIONER OF PARKS
John T. Carroll
CONSULTING ENGINEER
Anthony ...
CHIEF ENGINEER

DRAWN BY G.L.
CHECKED BY J.B. & H.W.
William J. ...
CONSULTING ENGINEER
Anthony ...
ENGINEER OF DESIGN

FILED IN OFFICE OF BOROUGH OF MANHATTAN
SEPT 12 1955