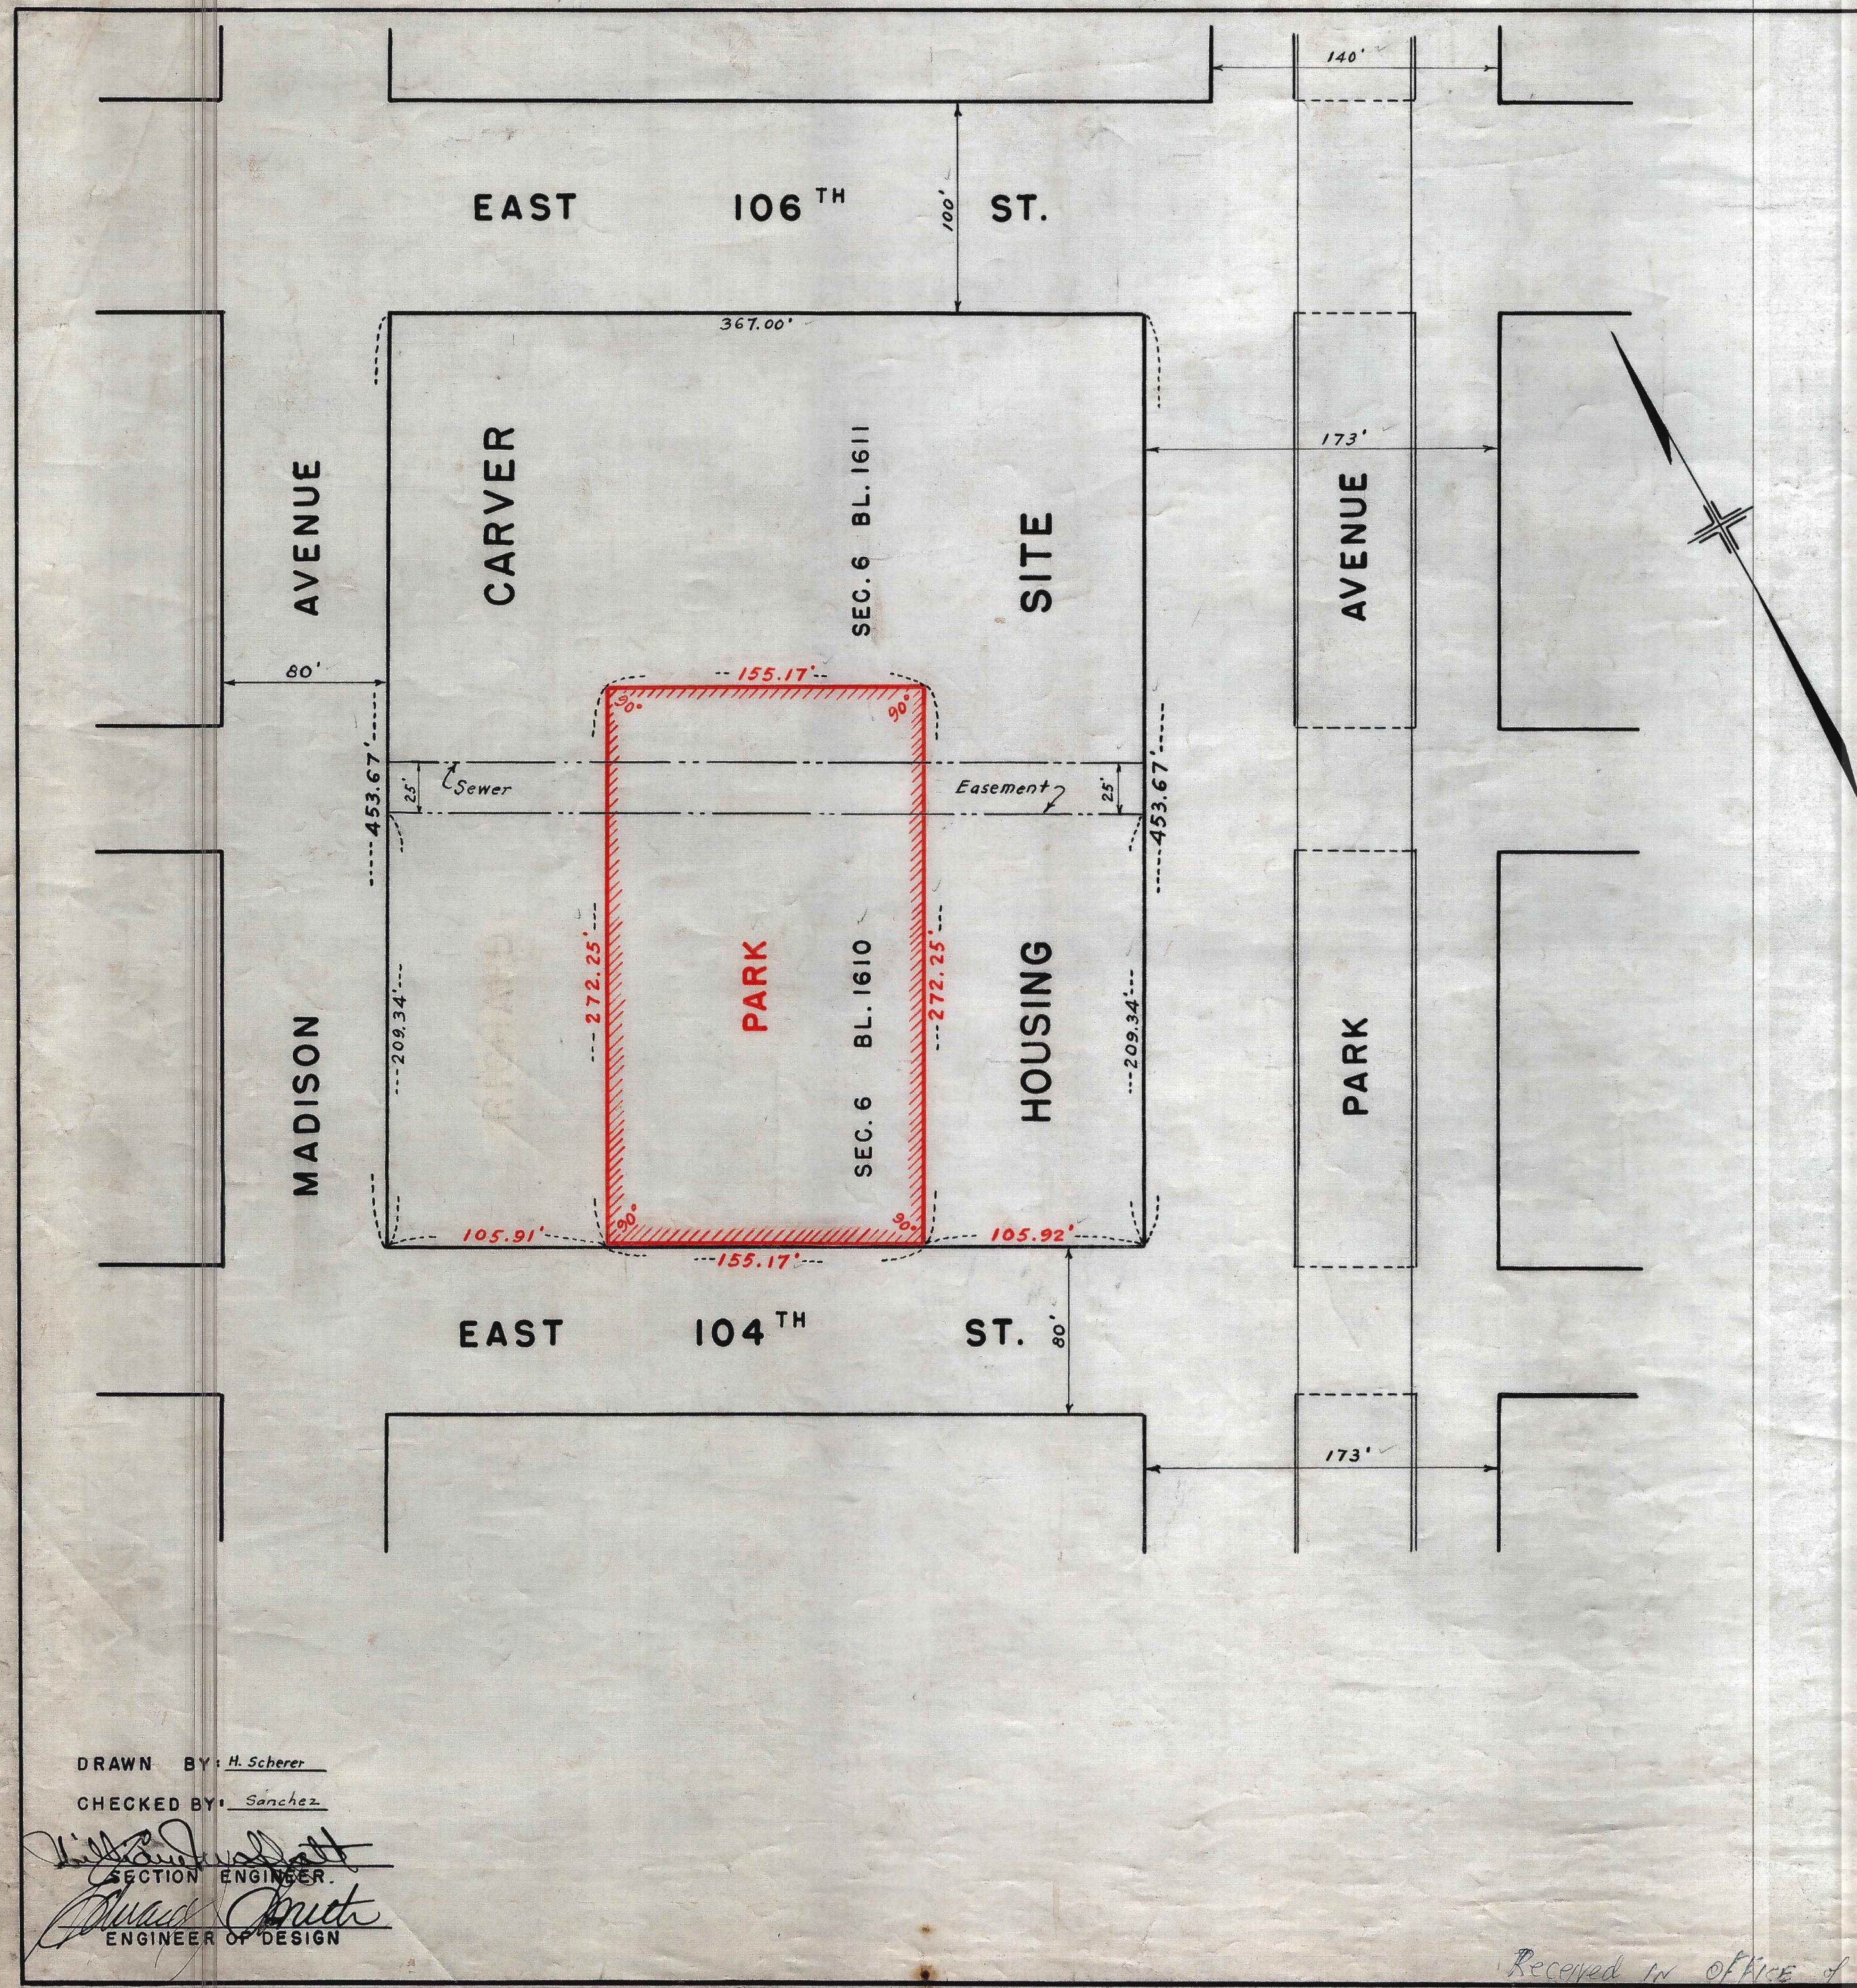




# NOTES

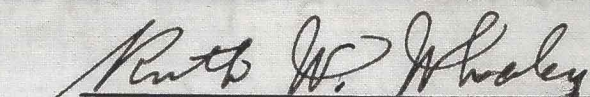
LINES AND DIMENSIONS PREVIOUSLY ESTABLISHED AND HEREBY RETAINED ARE SHOWN BY FULL BLACK LINES AND BLACK FIGURES.

LINES AND DIMENSIONS HEREBY ESTABLISHED ARE SHOWN BY FULL RED LINES AND RED FIGURES

PARK HEREBY ESTABLISHED SHOWN THUS..... 

I, RUTH W. WHALEY SECRETARY OF THE BOARD OF ESTIMATE OF THE CITY OF NEW YORK DO HEREBY CERTIFY THAT THIS MAP IS ONE OF FIVE SIMILAR MAPS ADOPTED BY THE SAID BOARD OF ESTIMATE ON THE 22 DAY OF MAY 1958

DATED: NEW YORK JULY 3 1958

  
SECRETARY BOARD OF ESTIMATE  
H-7.

CITY OF NEW YORK  
OFFICE OF THE PRESIDENT BOROUGH OF MANHATTAN  
DEPARTMENT OF BOROUGH WORKS

MAP SHOWING A CHANGE IN THE CITY MAP  
BY LAYING OUT

## A PARK

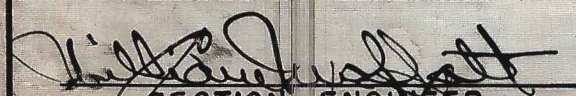
ON THE NORTHERLY SIDE OF EAST 104<sup>TH</sup> STREET  
BETWEEN PARK AVENUE AND MADISON AVENUE

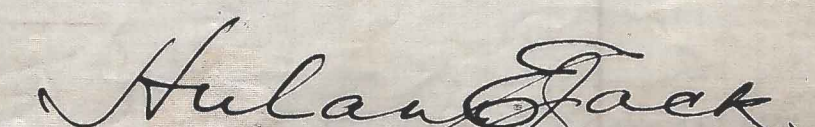
DATED: DEC. 17, 1953.

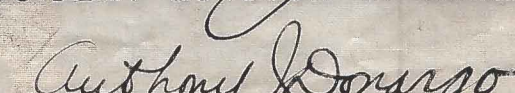
SCALE 1" = 60'

DRAWN BY: H. Scherer

CHECKED BY: Sanchez

  
SECTION ENGINEER  
  
ENGINEER OF DESIGN

  
PRESIDENT BOROUGH OF MANHATTAN

  
CHIEF ENGINEER

Received in Office of Boro. Pres. Manhattan  
July 18, 1958 G.K.M.

ACC. 29533