


AVENUE
TENTH

AVENUE
NINTH

WEST 28TH STREET

WEST 27TH STREET

WEST 26TH STREET

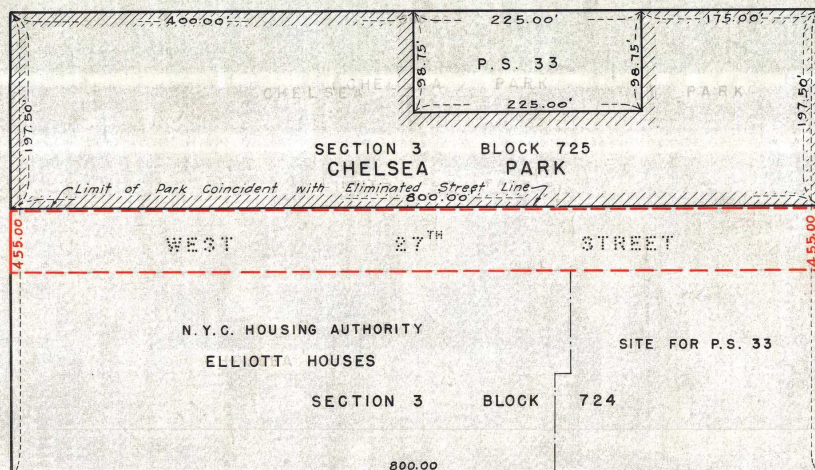

I, HILDA G. SCHWARTZ, SECRETARY OF THE BOARD OF ESTIMATE OF THE CITY OF NEW YORK, DO HEREBY CERTIFY THAT THIS MAP IS ONE OF FOUR SIMILAR MAPS ADOPTED BY THE SAID BOARD OF ESTIMATE ON THE 28TH DAY OF MARCH, 1946.

DATED: NEW YORK April 24, 1946

Hilda G. Schwartz
SECRETARY, BOARD OF ESTIMATE

LEGEND

LINES AND DIMENSIONS OF STREETS PREVIOUSLY ESTABLISHED AND HEREBY RETAINED ARE SHOWN BY FULL BLACK LINES AND BLACK FIGURES.

LINES AND DIMENSIONS OF STREETS HEREBY ESTABLISHED ARE SHOWN BY FULL RED LINES AND RED FIGURES.

LINES OF STREETS PREVIOUSLY ESTABLISHED AND HEREBY DISCONTINUED ARE SHOWN BY DASHED RED LINES.

PARK INDICATES PARK HERETOFORE ESTABLISHED.

CITY OF NEW YORK
OFFICE OF THE PRESIDENT, BOROUGH OF MANHATTAN
DEPARTMENT OF BOROUGH WORKS

MAP SHOWING
A CHANGE IN THE STREET SYSTEM
BY ELIMINATING THE LINES OF

WEST 27TH STREET

BETWEEN
NINTH AVENUE AND TENTH AVENUE

DATED: NOV. 27, 1945 SCALE 1" = 80'

Edgar Wallace Jr.
PRESIDENT, BOROUGH OF MANHATTAN

Dean G. Edwards
CHIEF ENGINEER

Charles W. Williams
COMMISSIONER OF BOROUGH WORKS

SECRETARY, BOARD OF ESTIMATE

DRAWN BY: *EHK*
CHECKED BY: *ES*

William J. Hall
SECTION ENGINEER
J. C. Collier
ENGINEER OF DESIGN

Drawn 16

ACC. No. 28696

B